
E¼ Cor SEC. 13-101-15

Mower Co. Record State Imp Stone.

JHS Crew Day with Mower Co. Backhoe, Dug a 3'x6' Hole, Found this Area had been Dug before, Dug 4'± deep to Virgin Soil, Tunneled & Probed East & West, Area Dug Before Appeared to 2'± wider than we opened, Found NO Evidence of Stone.

Set Corner using Co. Road Plan. Set 5/8"x16" Iron with with Cast Iron Mon. Over @ Rd Surface.

RE	POL.
BS	NE Cor
FD	947.09
FS	SE Cor
Δ	180°00'00"
D	4323.20

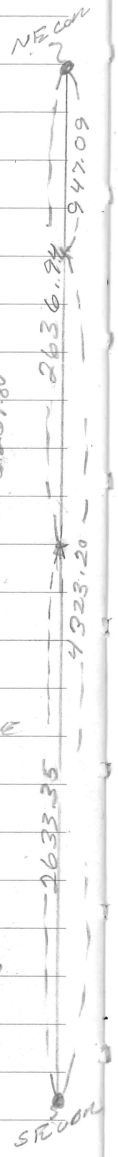

10-22-98
Cloudy
60°
HLS
JPA

29

