
S 1/4 Cor Sec 12-101-18

6-24-87 See Book 294 Page 44-45
Dug 12' x 12' x 3.5' deep hole on ℄ of E-W road in line with fence north and found nothing.

Placed 5/8" ø @ split on a straight line between sec cor ℄ of E-W road and 9' E of fence north

7-25-03 Fd 5/8" ø 12'± East of fence on ℄ of road.

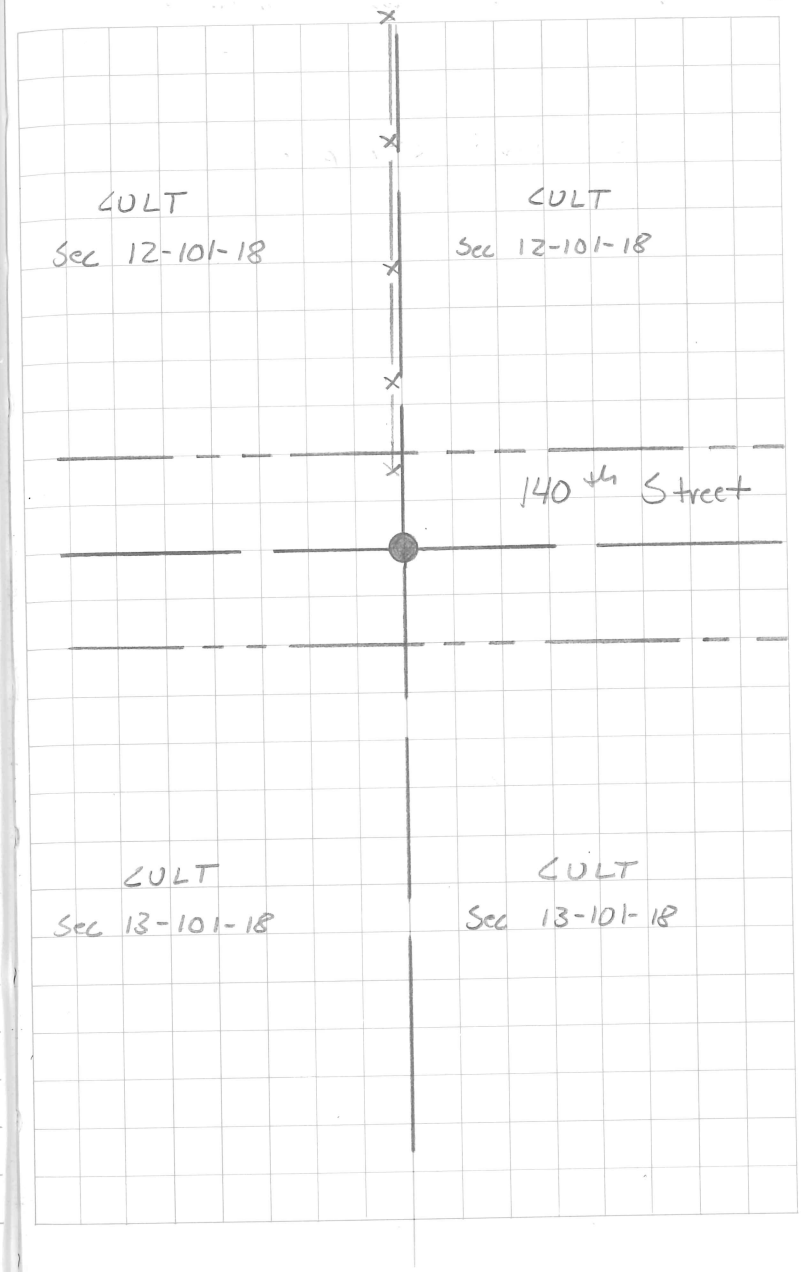

1-30-05
cloudy
300

HLS
MHS

37

¼ COR SEC. 12-101-18

6-24-87 SEC. BOOK - 294 pg 44
8-30-88

JHS CREW UNCOVERED
~~½"ø~~ - 5/8"ø 9.5' ± EAST
of N. LINE FENCE.

