SE cor SEC. 13-101-18
Cert. Filed 11-20-01


1922 INP STONE

1967 INP CONC MON OVER STONE.

JHS CREW with MOWING CO.
BACKHOE, UNCOVERED
CAST IRON MON .60± BELOW
ROAD SURFACE.

ACCEPTED MON AS TRUE
CORNER AND TIED OFF.

10-09-01
Cloudy
60°
HLS
CPU

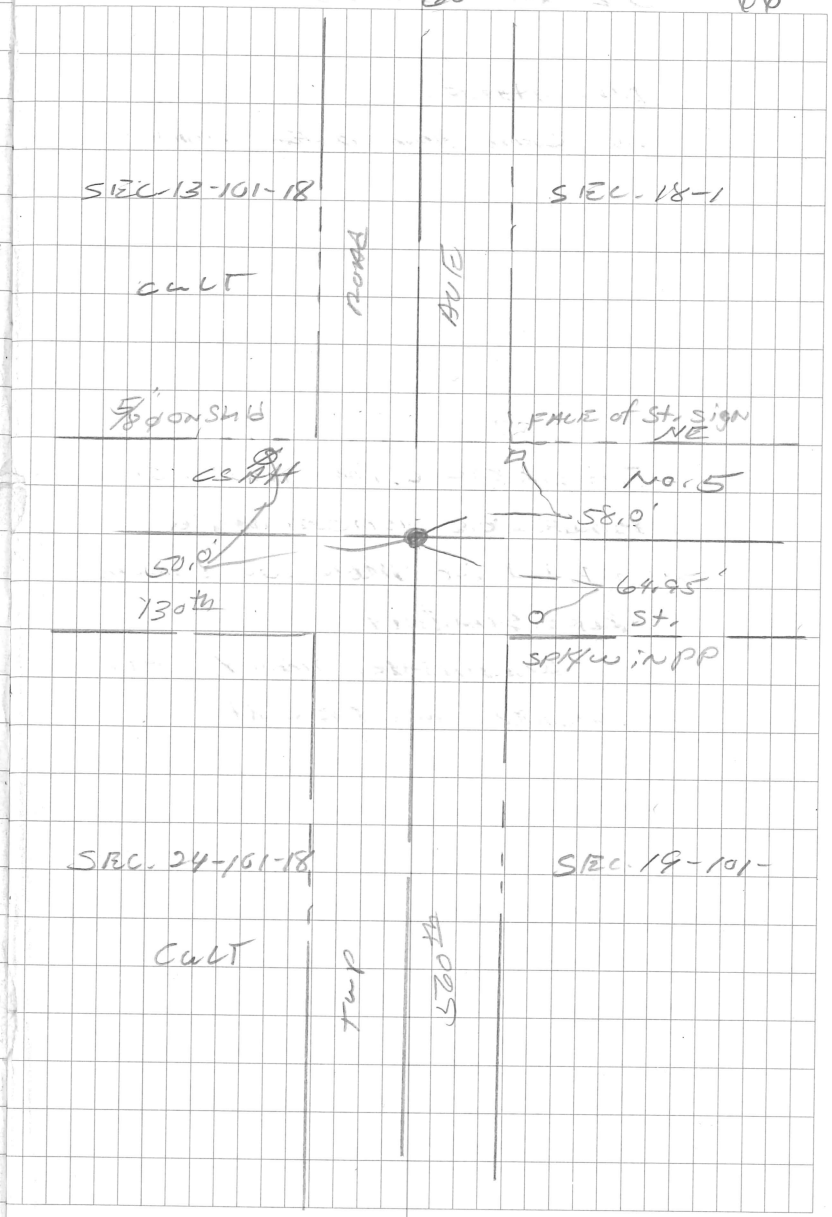

NW COR SEC. 19-101-17

Certificate Filed by JHS

1967 MOWER CO. RECORDS STATE INV

COMC. MON OVER STONE.

NOTE NEW INFORMATION

JHS CREW DUG BY HAND AND

COVERED CAST IRON MON.

.30± BELOW ROAD SURFACE.

5-12-00

CLOUDY & LIGHT RAIN HLS

DEL

50

50

