SE Cor Sec 20-101-18


Cert. Filed 12-15-92 by JHS

Dug with Co. back hoe and uncovered a 5/8" ø iron x 3" long lying flat 0.2' deep cont digging & found a 6"x8"x10" pointed field stone over a 8"x15" pointed fld stone 2' deep in virgin soil set CIM on east side of stone.

5-27-03 (SAT, EJM)

UNCOVERED CIM PULLED NEW TIE TO PP 62.84'

7-29-92 DRR JHS KTW 17°

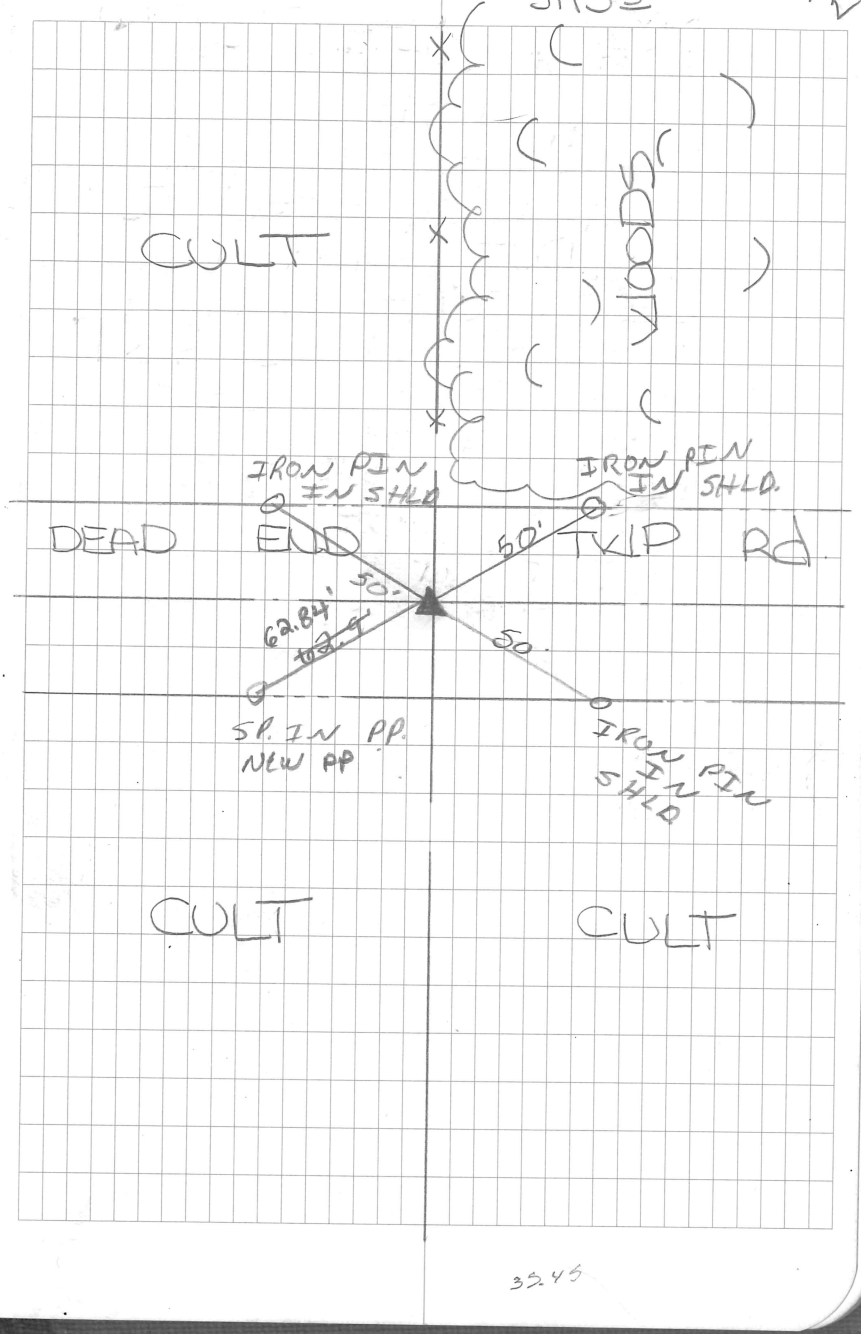

35.45