
May 25, 1994
SJT
V
34

NE cor Sec 30 - 102 - 16

Cert. Filed 8-94 by JHS

Found set CIM	A	B	C
	29.63	49.19	45.03

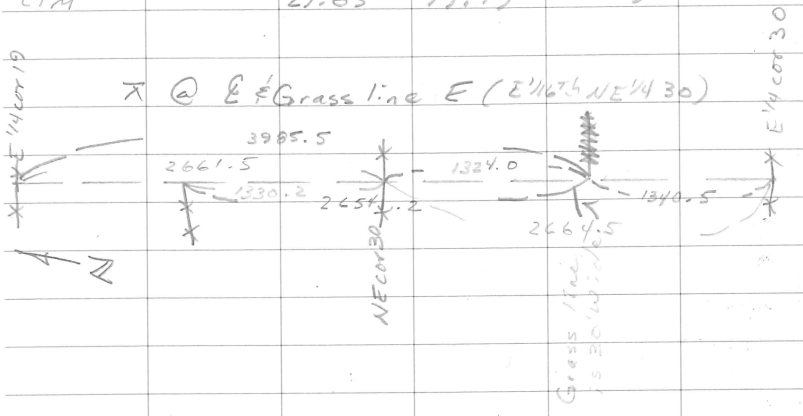

1891 Clausen shows stone @ corner

Exc. w Backhoe 10' E-W x 12' N-S x 3.5' Deep to virgin soil fd. nothing

set CIM on ℄ of Fences E & W 1/16th's Fences fit N-S

