8-6-97 HLS
Cloudy TRS
75


24

SE cor SEC. 27 - 103-14

No Information Found in Mower Co. Records

"Note" → Cut CABLE in ℄ of E-W Twp. Rd. Not MARKED.
US WEST CABLE MARKED on N. Sh'd of Rd. CROSSES Rd. 100± EAST of INTERSECTION, TO TEL PED on NW CORNER of R/W of SEC. 35. APPEARS to be OLD CABLE Check with FARM SITE. THEY HAVE PHONE WORKING.
JHS CREW Dug on ℄ of E-W TWP Rd. & Twp Rd. South Dug a 5'X10' HOLE 4.0' DEEP AND FOUND NO. EVIDENCE of PLS CORNER, SET 5/8" X 16" IRON with CAST IRON MON. ON ℄ of E-W Twp Rd. & ℄ of Twp Rd. South.
-40 BELOW Rd. SURFACE.

8-15-6 JHS CREW FD CIM SHOT FOR BASE MAP

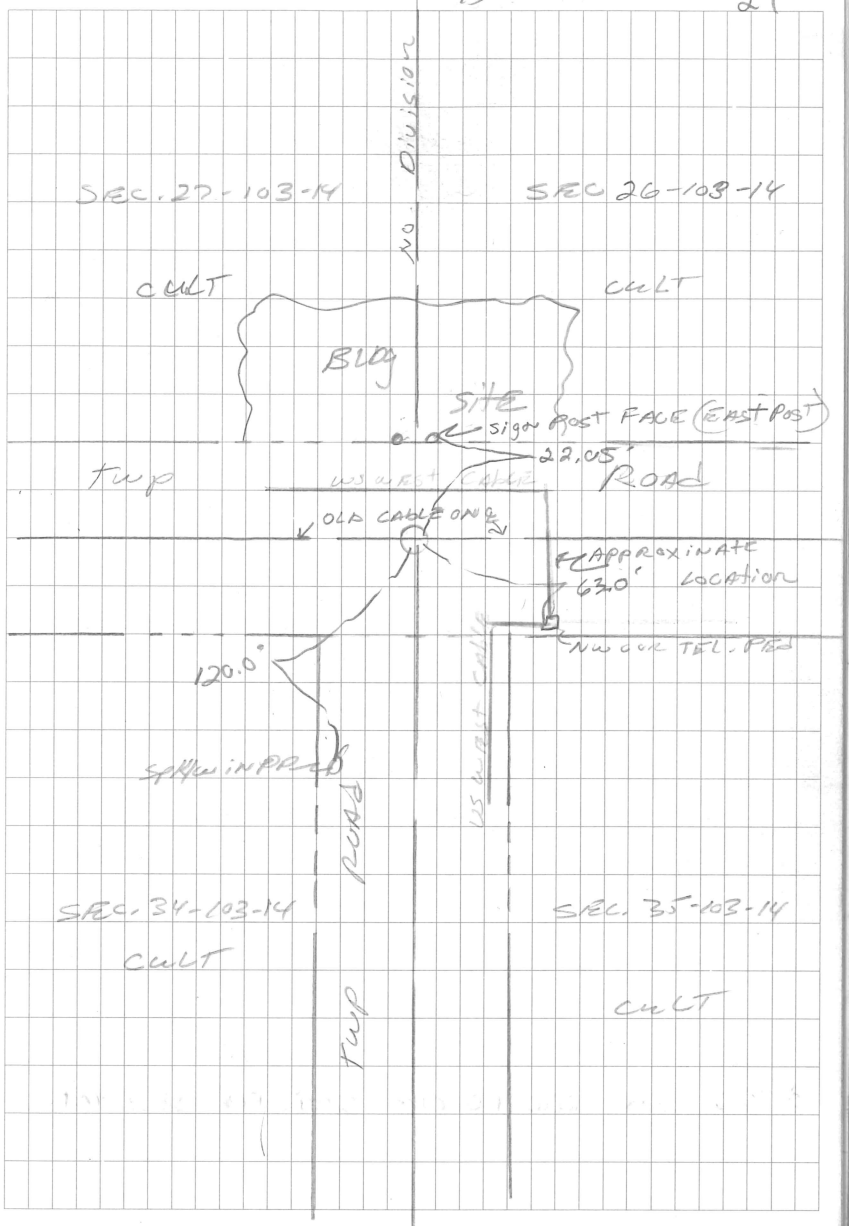

SEC. 26-103-14

COUT PH 67

TO	POL (2)		
BS	FD BRASS CAP (1) SEC. 26		
D	1782.05		
FS	TR. PT (3)		
∠	141° 56' 35"	4255.63	

IN

TO	TR. PT. (3)		
BS	POL (2)		
D	—		
FS	CFP (4)		
∠	303° 47' 34"	5289.60	
FS	CFP (6) @ 1/16th LINE		
∠	331° 49' 49"	2872.38	
FS	SW (5) COR SEC. 26		
∠	215° 28' 00"	196.72	

IN

10-15-02
Cloudy
45°
HLS
FPB

64

