
SE COR SEC. 20-103-15

NO INFORMATION FOUND IN MOWER CO. RECORDS.

JHS CREW dug with RAY TUCKER BACKHOE Dug a 6"± x 12"± HOLE AND FOUND NO EVIDENCE of PLS CORNER

JHS - SET COR ON ℄ TWP ROAD .2 DOUBLED DIST FROM E1/4 COR TO 1/16 FENCE LINE TO WEST

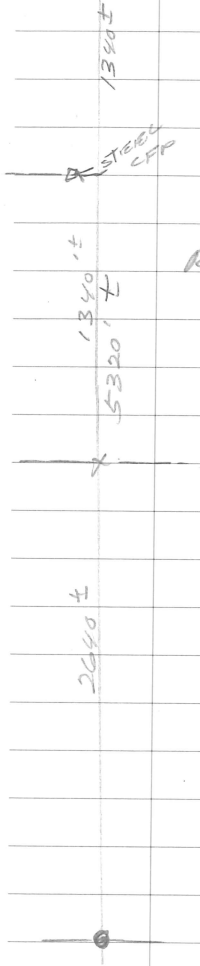

8-3-06 Cloudy 80°

HLS MDH 59

