
12-8-99
CLEAR
40°

HLS
DEK

46

E¼ COR SEC. 25-104-18

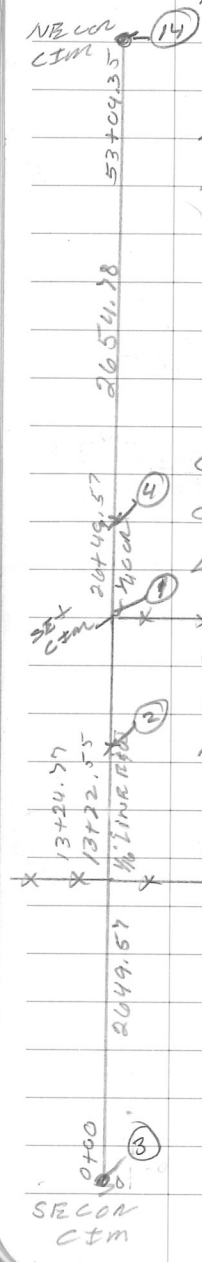

NO INFORMATION FOUND IN MOWER CO. RECORDS

JHS CREW DUG WITH MOWER CO. BACKHOE ON CENTERLINE OF ROAD AND IN LINE WITH LINE FENCE EAST.

DUG A 6' X 8' HOLE FOUND OLD ROAD BED @ 1.5' CONTINUED DIG TO VIRGIN SOIL AND FOUND NO EVIDENCE OF PLS CORNER

SET CORNER OF STRAIGHT LINE BETWEEN SE COR & NE COR.

@ DIST OF 2649.57 FROM SE COR.

SET ⅝" X 16" IRON WITH CAST IRON MON. .40 ± BELOW ROAD SURFACE.

