


15TH STREET SE & 22ND AVENUE SE

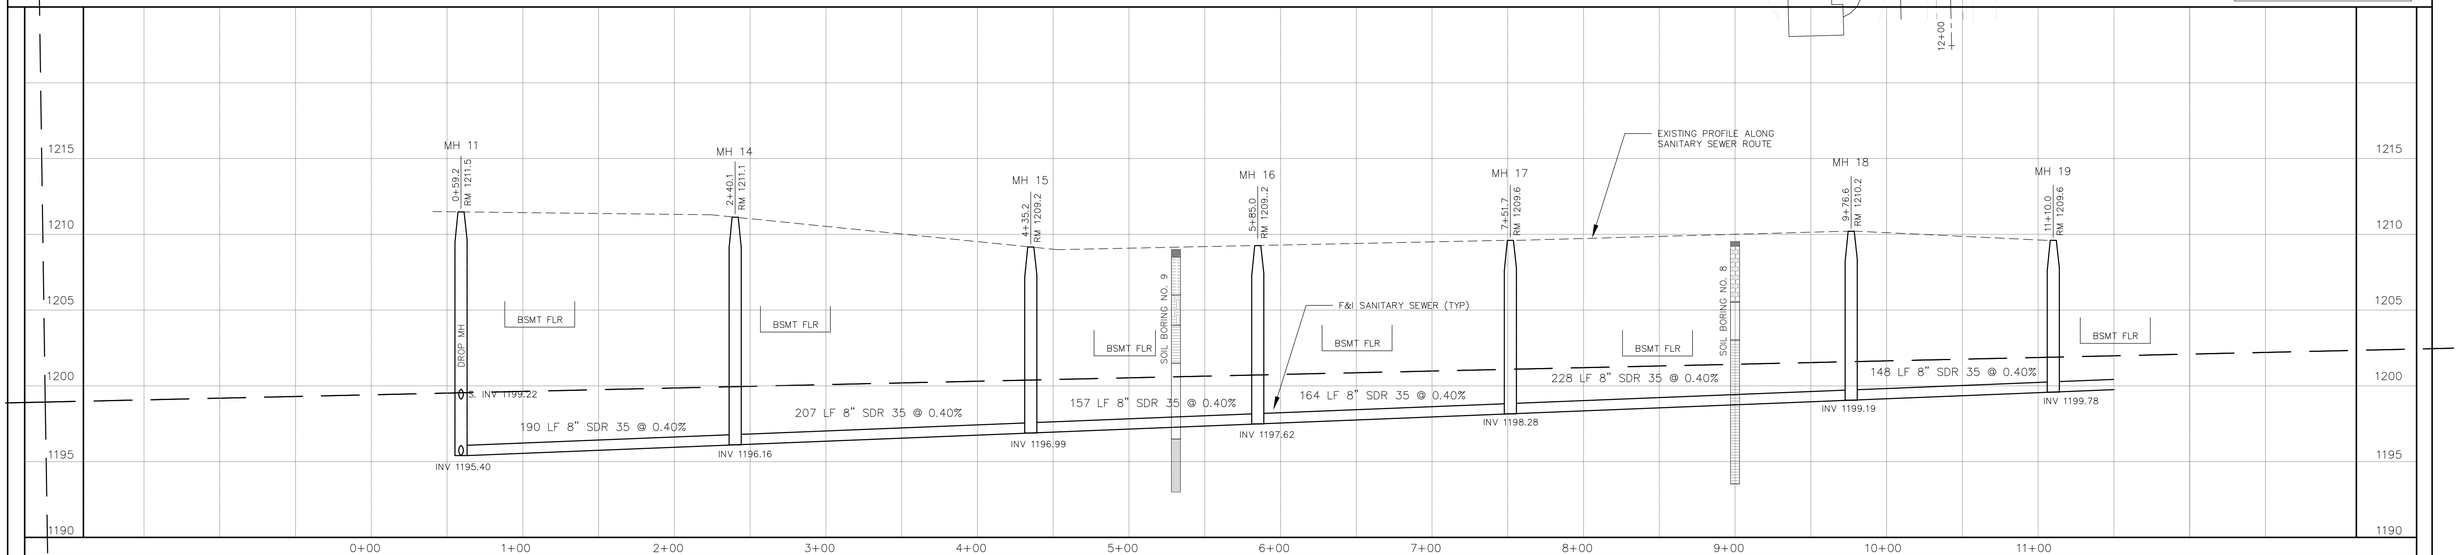

50 0 50 HORIZ. SCALE FEET

5 0 5 VERT. SCALE FEET

COPYRIGHT
by JONES, HAUGH & SMITH INC
This drawing and format are protected by Copyright and all rights are reserved. The use of this drawing and format is strictly prohibited without the written consent and permission of Jones, Haugh & Smith Inc.

No responsibility is accepted for the locations of utilities shown hereon. Verification of actual locations should be requested prior to the commencement of construction or the taking of any other action relying on the actual locations.

GOPHER STATE ONE-CALL: 1-800-252-1166

REV.	BY	DATE

JONES, HAUGH & SMITH INC
CONSULTING ENGINEERS & LAND SURVEYORS
PH. 507-373-4876
515 SOUTH WASHINGTON AVENUE
ALBERT LEA, MINNESOTA 56007

DESIGNED: X
DRAWN: X
CHECKED: BJJ
DATE: FEBUARY, 2004
FILE NO: 96-392C-P1.DWG

I hereby certify that this plan, specification, or report was prepared by me or under my direct supervision and that I am a duly Registered Professional Engineer under the laws of the State of Minnesota.

Brian J. Johnson
Reg. No. 42744 Date:

CITY OF AUSTIN, MN
2004 SANITARY SEWER IMPROVEMENTS
BELLEMANS 1ST & 2ND RESTRICTED SUBDS.
15TH ST. SE – AS-BUILT

SHEET 6 OF 9