Index No. _____

CERTIFICATE OF LOCATION OF GOVERNMENT CORNER

W1/4 Corner of Section 27, Township 101N, Range 14 W, 5th P.M.

STATE OF MINNESOTA, County of MOWER


At the corner location shown on the sketch:

☒ On 5-14-91 (DATE) found a triangular shaped pointed limestone

☐ left monument as found, ☐ lowered monument, ☐ removed monument (explain)

☒ On 5-14-91 (DATE) placed a 5/8"Ø x 18" iron on South side of stone, set cast iron monument over stone on surface.

SKETCH OF REFERENCE TIES

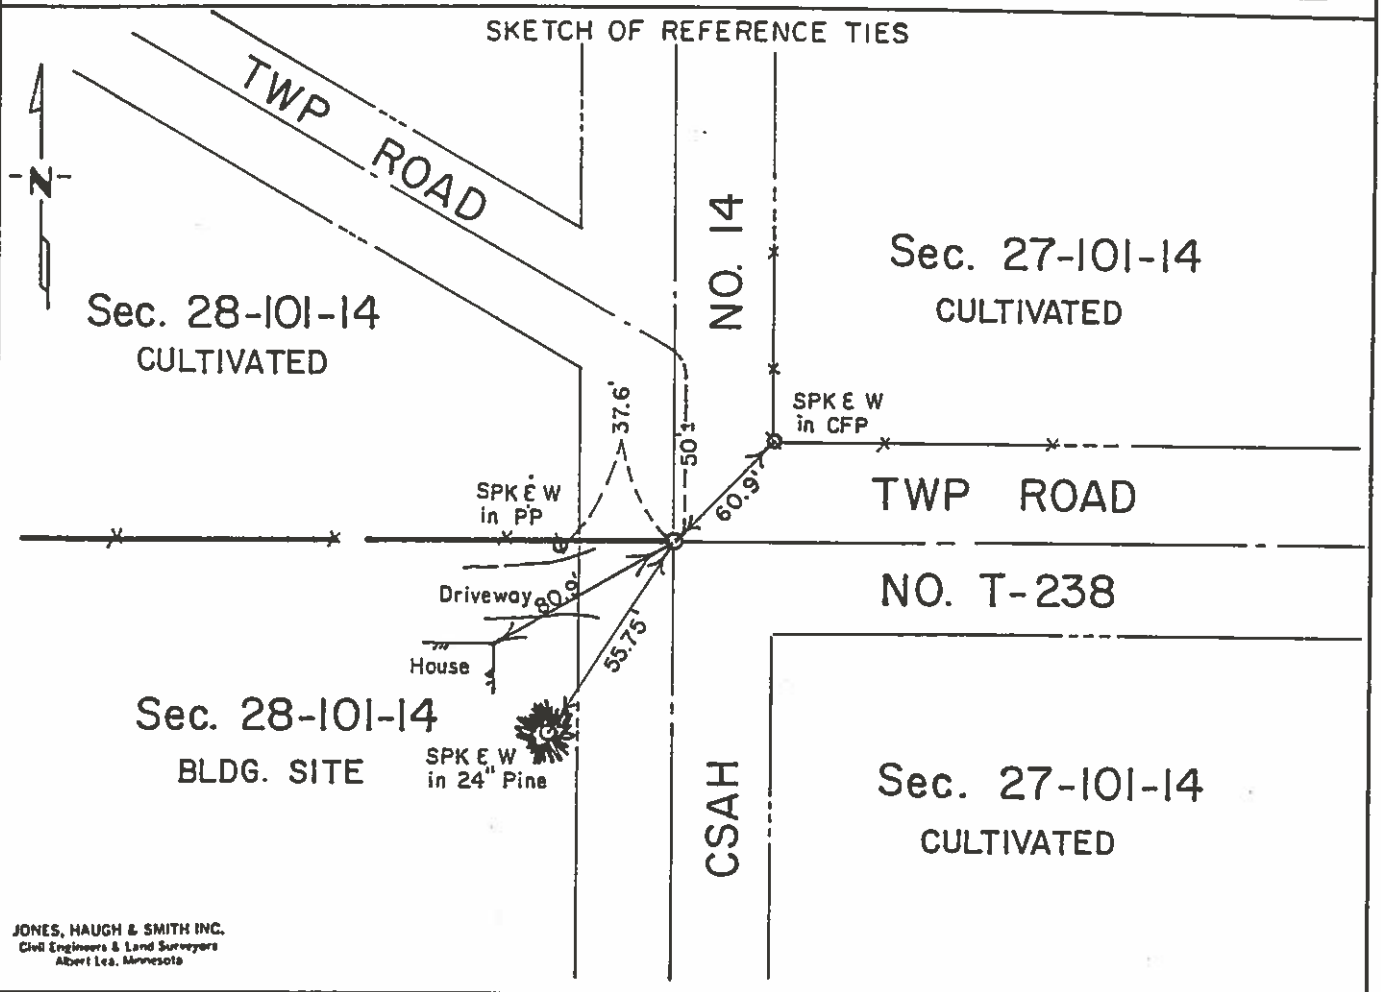

JONES, HAUGH & SMITH INC.
Civil Engineers & Land Surveyors
Albert Lea, Minnesota

Statement of evidence relative to this corner location is on back of page.

I hereby certify that this document and the data contained herein was prepared by me or under my direct supervision.

SIGNATURE _____ DATE 5-16-91

Registration No. 13807

☒ Land Surveyor, ☐ Professional Engineer

☐ County Surveyor, ☐ County Engineer

OFFICE OF THE COUNTY RECORDER

County of _____

I hereby certify that this document was filed in the County Rec. office at _____ .M. on the _____ day of _____ A.D., 19__

COUNTY RECORDER _____

By _____, Deputy

DOCUMENT NO. _____

M.H.D. FORM NO. 2105

STATEMENT OF EVIDENCE

W 1/4 corner Section 27-101-14

This corner was originally established by Deputy Surveyor John Quigley of the U.S. General Land Office in 1853. The government notes show a wood post was set with a mound of earth and trench. The following ties were taken:

6" Burr Oak N 70° E 19 links (12.54 ft)
8" Burr Oak S 51° W 158 links (103.62 ft)

The following were contacted for section corner information:

Mower County Highway Department
Mower County Recorder
Zenk Engineering
Tucker Land Surveying

The following information was obtained to support evidence of a perpetuation of the original PLS corner:

Book "A" in the Mower County Engineering Office shows a concrete monument inplace and ties were taken:

46.0 SE to iron stake
42.9 SW to 18" Pine
80.9 SW to NE corner house
89.2 SE to brass disk in power pole

1950 County grading plan shows a 1/2" diameter iron inplace on centerline centerline of N-S-E roads found during grading project SAP 50-526-01.

1974 Jones, Haugh & Smith Inc crew uncovered a 2 1/2" diameter pipe 2' deep on centerline N-S-E roads. Set a 5/8" diameter x 24" iron over the pipe.

1991 Jones, Haugh & Smith Inc crew, under the direction of John H. Schulte, dug on centerline centerline and uncovered a 3/4" diameter x 12" long iron over a capped 5/8" diameter iron. Continued digging and uncovered a 2 1/2" diameter bearing race (looks like a pipe before removing). Continued digging and uncovered a triangular shaped, pointed limestone 4' deep in virgin soil. Placed a 5/8" diameter iron on the south side of stone and set cast iron monument over the stone on the road surface. The 5/8" diameter x 24" iron was 1.0' west and 0.4' south of the stone.

The monument agrees with records and ties from Book "A" and fits occupation and road centerlines within the section and is accepted as best evidence of a perpetuation of the original public land survey corner.