Index No. _____

CERTIFICATE OF LOCATION OF GOVERNMENT CORNER

W1/4 Corner of Section 22, Township 101N, Range 14W, 5th P.M.

STATE OF MINNESOTA, County of MOWER


At the corner location shown on the sketch:

☐ On 5-14-91 (DATE) found a 2 1/2"Ø brass pipe capped RLS 4423

☐ left monument as found, ☐ lowered monument, ☐ removed monument (explain)

☐ On 5-14-91 (DATE) placed a cast iron monument over pipe found.

SKETCH OF REFERENCE TIES

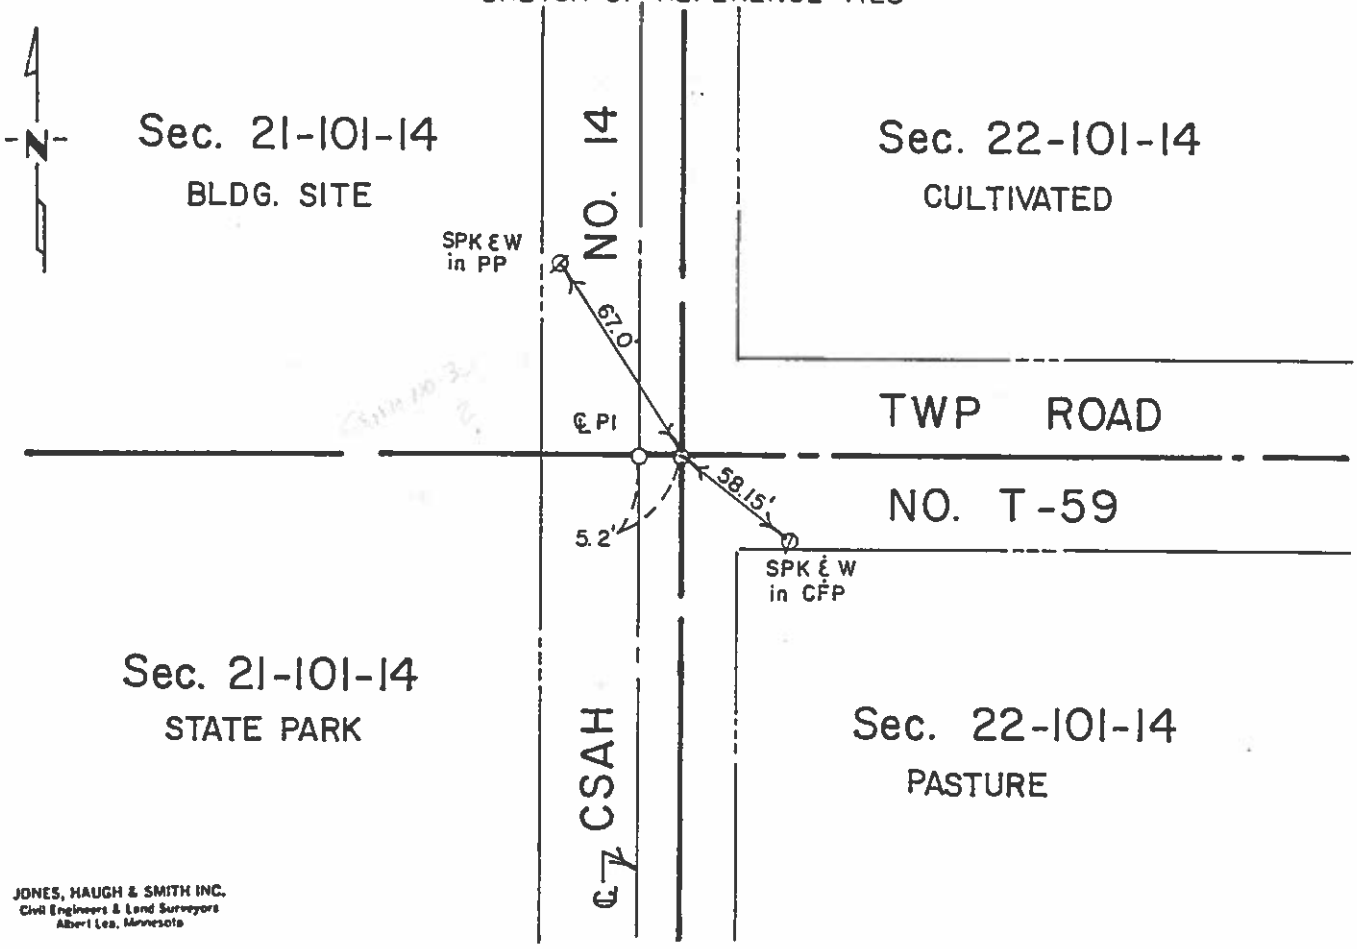

Statement of evidence relative to this corner location is on back of page.

I hereby certify that this document and the data contained herein was prepared by me or under my direct supervision.

SIGNATURE _____ DATE 5-16-91

Registration No. 13607

☒ Land Surveyor, ☐ Professional Engineer

☐ County Surveyor, ☐ County Engineer

OFFICE OF THE COUNTY RECORDER

County of _____

I hereby certify that this document was filed in the County Rec. office at _____ .M. on the _____ day of _____ A.D., 19 ___

COUNTY RECORDER _____

By _____, Deputy

DOCUMENT NO. _____

M.H.D. FORM NO. 2105

STATEMENT OF EVIDENCE

W 1/4 corner Section 22-101-14

This corner was originally established by Deputy Surveyor John Ball of the U.S. General Land Office in 1853. The government notes show a wood post was set with a mound of earth and trench. The following ties were taken:

10" Black Oak	N 52 3/4° W	92 links	(60.72 ft)
6" Black Oak	S 1/2° E	288 links	(190.08 ft)

The following information was obtained to support evidence of a perpetuation of the original PLS corner.

1950 County grading plan shows monument inplace for grading project.

1967 A corner Certificate was filed and recorded in the office of the County Engineer, and notes recorded in Book "A" shows a 2" diameter x 15" brass capped pipe was placed by C.D. Hosfield, RLS 4423, over concrete monument and ties were taken.

1991 Jones, Haugh & Smith Inc crew uncovered a 2 1/2" brass capped pipe 5.2' more or less, east of centerline. PI checks and agrees with Hosfield's records. Placed a cast iron monument over pipe on the road surface.

The monument fits occupation and road centerlines within the section and is accepted as best evidence of a perpetuation of the original public land survey corner.

M TIE BOOK p 24

CHAPTER 359 LAWS OF 1921

CERTIFICATE OF LOCATION OF GOVERNMENT CORNER

Corner of Sec. 21 T. 101 N. R. 14 W.

STATE OF MINNESOTA } ss.
County of Mower }

I hereby certify that on 29th day of June 19 67
I found the—established E 1/4 Corner of said section
which was evidenced by concrete monument implace

and I further certify that to perpetuate the locaton of such corner I did at the exact location thereof place a permanent marker consisting of 2" X 15" Brass capped iron pipe flush with blacktop

I further certify that I established three
reference or witness monuments consisting of
which reference or witness monuments are located in the manner following:

Brass disc in S. side of power pole	WNW	66.80 feet
Brass disc in NW side of power pole	NE	55.10 feet
Brass disc in W. side of power pole	SE	116.30 feet
North and south road centerline	W	~~6.0~~ 5.2' feet
Road centerline to west	S	1.0 feet
Road centerline to east	N	1.0 feet

Said corner is on line between NE cor. & SE. cor. of said Section 21

Dated at Owatonna, Minn., this 27th day of July 19 67

C. D. Hosfield ~~County Surveyor~~
Registered Land Surveyor

OFFICE OF REGISTER OF DEEDS } ss.
County of }

I hereby certify that the within instrument was filed in this office for record on the
day of A. D. 19 at o'clock M.

Register of Deeds

By Deputy