Index No. _____

CERTIFICATE OF LOCATION OF GOVERNMENT CORNER

NE Corner of Section 15, Township 102N Range 14W, 5th P.M.

STATE OF MINNESOTA, County of MOWER


At the corner location shown on the sketch

☐ On 08/07/1997 (DATE) found a ALUMINUM MONUMENT

☒ left monument as found, ☐ lowered monument, ☐ removed monument (explain)

☐ On 08/07/1997 (DATE) placed a –

SKETCH OF REFERENCE TIES

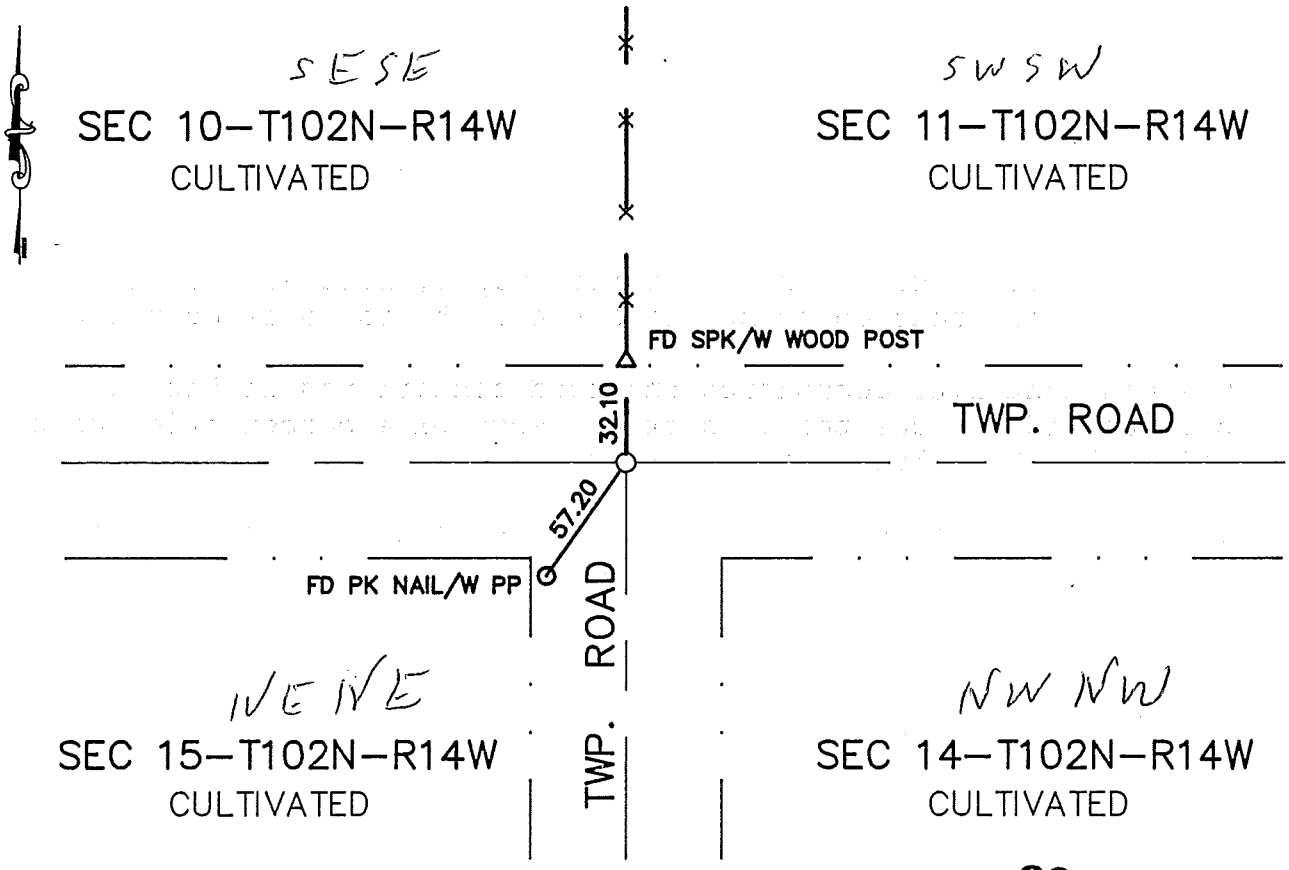

JONES, HAUGH & SMITH INC
Civil Engineers & Land Surveyors
Albert Lea, Minnesota

BOOK 96 PAGE 289

Statement of evidence relative to this corner location is on back of page.

I hereby certify that this document and the data contained herein were prepared by me or under my direct supervision.

SIGNATURE _____ DATE 9-9-97

Registration No. 13807

☐ Land Surveyor, ☐ Professional Engineer

☒ County Surveyor, ☐ County Engineer

OFFICE OF THE COUNTY RECORDER
County of Mower

I hereby certify that this document was filed in the County Rec. office at 2 P .M. on the 10 day of Sept A.D., 1997

COUNTY RECORDER Charles Enger

By Susan M. Davis, Deputy

DOCUMENT NO. 455999

M.H.D. FORM NO. 2105

Book 96 Misc Page 289

NE Cor SEC 15-102-14

This corner was originally established by Deputy Surveyor John Taylor of the U.S. General Land Office in 1853. The government notes show a wood post was set with mound of earth and trench.

The following were contacted for section corner information.

Mower County Highway Dept.
Mower County Recorder
Tucker Land Surveying

1995 Ray Tucker RLS 15471 located a stone and wood stake at the CL intersection of township roads E-W and south.

1997 Jones Haugh and Smith crew, under direction of John Schulte, Mower County Surveyor RLS 13807, dug by hand at location of magnetic signal at CL intersection of township roads E-W and South. Uncovered Mower County aluminum monument and found ties to nearby wood post and power pole. Accepted monument as best evidence of the original PLS corner and measured ties.

The monument fits occupation and road centerlines within the section and is accepted as best evidence of a perpetuation of the original public land survey corner.

For electronic survey data and analysis, contact the firm of Jones, Haugh and Smith Inc.