Index No. _____

CERTIFICATE OF LOCATION OF GOVERNMENT CORNER

NW Corner of Section 3, Township 102N, Range 16W, 5th P.M.

STATE OF MINNESOTA, County of MOWER


At the corner location shown on the sketch:

☐ On 5-10-91 (DATE) found a 2 1/2"Ø brass disk in a pipe on ℄℄ of N-S-E-W roads.

☒ left monument as found, ☐ lowered monument, ☐ removed monument (explain)

☐ On _____ (DATE) placed a _____

SKETCH OF REFERENCE TIES

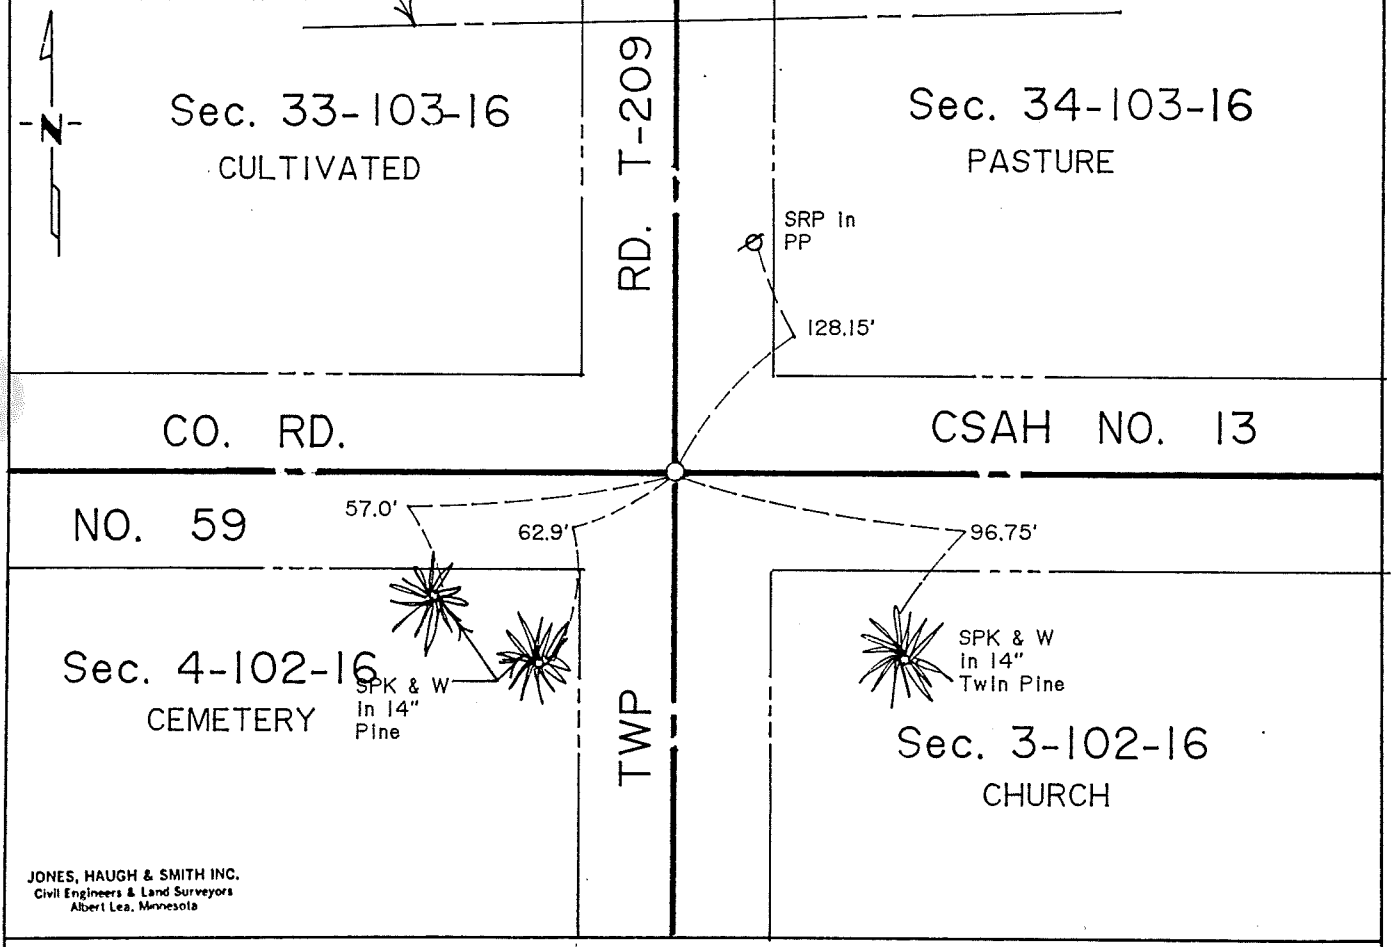

JONES, HAUGH & SMITH INC.
Civil Engineers & Land Surveyors
Albert Lea, Minnesota

Statement of evidence relative to this corner location is on back of page.

I hereby certify that this document and the data contained herein was prepared by me or under my direct supervision.

_____ (SIGNATURE) 5-16-91 (DATE)

Registration No. 13607

☒ Land Surveyor, ☐ Professional Engineer

☐ County Surveyor, ☐ County Engineer

OFFICE OF THE COUNTY RECORDER

County of _____

I hereby certify that this document was filed in the County Rec. office at _____ .M. on the _____ day of _____ A.D., 19__

COUNTY RECORDER _____

By _____, Deputy

DOCUMENT NO. _____

M.H.D. FORM NO. 2105

STATEMENT OF EVIDENCE

NW corner Section 3-102-16

This corner was originally established by Deputy Surveyor John Ball of the U.S. General Land Office in 1853. The government notes show a wood post and a handful of small stones were set with a mound of earth and trench.

The following were contacted for section corner information:
Mower County Highway Department
Mower County Recorder
Zenk Engineering
Tucker Land Surveying

The following information was obtained to support evidence of a perpetuation of the original public land survey corner:

1969 Book "A" in the office of the Mower County Engineer shows a 2" x 30" brass capped iron pipe flush with road surface on centerline centerline of N-S-E-W roads. The following ties were recorded:
128.0' NNE to brass disc in power pole
88.3' WSW to brass disc in telephone pole
49.5' SE to brass disc in telephone pole

1970 Jones, Haugh & Smith Inc crew uncovered a 2 1/2" diameter brass capped pipe RLS 4423, C.D. Hosfield, centerline centerline on N-S-E-W roads during survey in NE 1/4 NE 1/4 Section 4-102-16.

1978 Jones, Haugh & Smith Inc crew placed a concrete nail and washer in bituminous surface using ties from 1969 still intact.

1991 Jones, Haugh & Smith Inc crew, under the direction of John H. Schulte, dug on centerline centerline for bituminous overlay project SAP 50-613-08. Uncovered a 2 1/2" diameter brass capped pipe, RLS 4423, on centerline centerline of N-S-E-W roads set by C.D. Hosfield in 1969. Left monument as found and new ties were recorded.

The monument fits occupation and road centerlines within the section and is accepted as best evidence of a perpetuation of the original public land survey corner.