"G" TIE BOOK P16

# CERTIFICATE OF LOCATION OF GOVERNMENT CORNER


N 1/4 Corner to Section 11 Township 103N Range 14W No. 13

STATE OF MINNESOTA,


County of Mower S.S.

I hereby certify that on the 29th day of November, 1966, that I, Leonard Sankstone, a Registered Land Surveyor, found the North quarter corner of Section 11, T103N, R14W, which was evidenced by a 4"x6"x18" limestone monument with chiseled "X", 72" below grade, and I further certify that to perpetuate the location of such corner I did, at the exact location thereof, place a permanent marker consisting of 3"x20" cast iron Ferro magnetic monument. I further certify that I established 4 references or witness monuments consisting of 2 corner fence posts, 1 telephone pole, 1 power pole, which reference or witness monuments are located in the manner following.

NW 68.62 ft. Corner Fence Post (N&B cap)
NE 57.48 ft. Telephone Pole (N&B cap)
SE 49.32 ft. Corner Fence Post (N&B cap)
SW 72.18 ft. Power Pole (N&B cap)
(5.50 E of centerline U.S. Hwy.63) Approx. Location

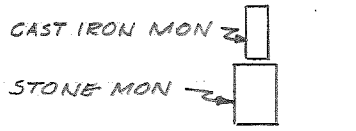


SECTION

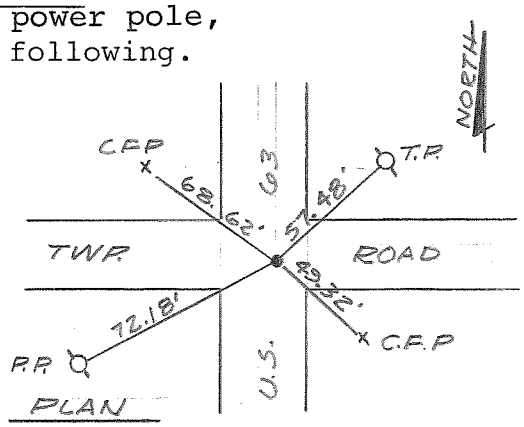


Dated at Rochester, Minnesota, this 1st day of December, 1966.

Distance to NW corner Sec. 11 = 2641.70
Distance to NE corner Sec. 11 = 2656.73

Leonard Sankstone

Leonard Sankstone
Registered Land Surveyor No. 5325

OFFICE OF THE REGISTER OF DEEDS

County of _____

I hereby certify that the within instrument was filed in this office for record on the _____ day of _____ A.D., 19____.

280014

8 Dec 66
11 misc a 143

_____
Register of Deeds

BOOK 25 PAGE 143