BOOK 25 PAGE 142 "E" TIE BOOK p 16

CERTIFICATE OF LOCATION OF GOVERNMENT CORNER


NE Corner to Section 11 Township 103N Range 14W No. 12


STATE OF MINNESOTA,

County of Mower S.S.

I hereby certify that on the 29th day of November, 1966, that I, Leonard Sankstone, a Registered Land Surveyor, found the Northeast corner of Section 11, T103N, R14W, which was evidenced by 18"x18"x18" stone monument witnessed by a 1/2"x12" bolt on north edge, 72" below grade, and I further certify that to perpetuate the location of such corner I did, at the exact location thereof, place a permanent marker consisting of 1" iron pipe & set bolt inside pipe, 8" below grade. I further certify that I established 3 references or witness monuments consisting of 2 fence posts, 1 power pole, which reference or witness monuments are located in the manner following.

N 29.83 ft. Power Pole (N&B cap)
SE 42.26 ft. Corner Fence Post (N&B cap)
S 56.75 ft. Corner Fence Post (N&B cap)

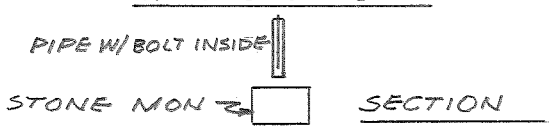

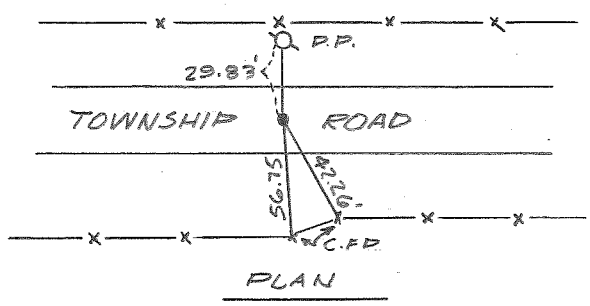

Dated at Rochester, Minnesota, this 1st day of December, 1966.

Distance to N1/4 Sec. 11 - 2656.73

Leonard Sankstone

Leonard Sankstone

Registered Land Surveyor No. 5325

OFFICE OF THE REGISTER OF DEEDS

County of _____

I hereby certify that the within instrument was filed in this office for record on the _____ day of _____ A.D., 19____.

28001.3

8 Dec 66
11 misc 25
142

_____

Register of Deeds

_____