BOOK 25 PAGE 146

TIE BOOK p86

CERTIFICATE OF LOCATION OF GOVERNMENT CORNER


N 1/4 Corner to Section 23 Township 103N Range 14W No. 16

STATE OF MINNESOTA,

County of Mower S.S.

I hereby certify that on the 25th day of November, 1966, that I, Leonard Sankstone, a Registered Land Surveyor, ~~xxxxx~~ set the North quarter corner of Section 23, T103N, R14W, which was evidenced by one half the distance between the NE corner and NW corner of Section 23 and I further certify that to perpetuate the location of such corner I did, at the exact location thereof, place a permanent marker consisting of chiseled X on west bridge truss.

I further certify that I established 3 references or witness monuments consisting of 2 trees, 1 power pole, which reference or witness monuments are located in the manner following.

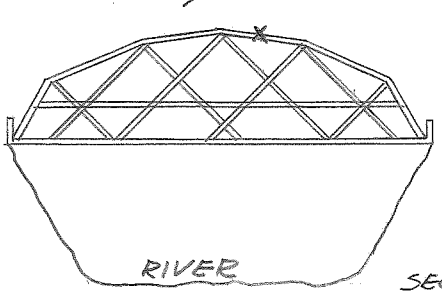


SECTION

NW 148.40 ft.
24" Twin Oak (N&B cap)

SE 172.72 ft.
Power Pole (N&B cap)

SW 143.59 ft.
12" Twin Oak (N&B cap)

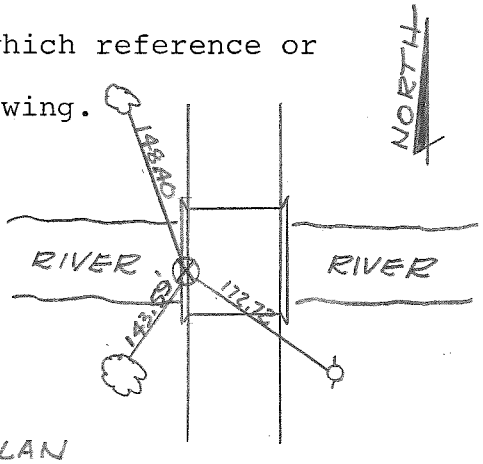

PLAN

Dated at Rochester, Minnesota, this 1st day of December, 1966.

Distance to NE cor. Sec. 23 = 2654.70'
Distance to NW cor. Sec. 23 = 2654.70'

Leonard Sankstone

Leonard Sankstone

Registered Land Surveyor No. 5325

OFFICE OF THE REGISTER OF DEEDS

County of _____

I hereby certify that the within instrument was filed in this office for record on the _____ day of _____ A.D., 19____.

280017

11 min a 8 Dec 66 23
146
Boyle M Epl
Register of Deeds
By Mark Epl Deputy

Register of Deeds