BOOK 25 PAGE 137 "I" TIE BOOK P. 90

# CERTIFICATE OF LOCATION OF GOVERNMENT CORNER


NW Corner to Section 22 Township 104N Range 14W No. 5

STATE OF MINNESOTA,


County of Mower S.S.

I hereby certify that on the 21st day of November, 19 66, that I, Leonard Sankstone, a Registered Land Surveyor, found the Northwest corner of Section 22, T104N, R14W, which was evidenced by 18" dia x 12" flat head stone monument, 48" below grade, and I further certify that to perpetuate the location of such corner I did, at the exact location thereof, place a permanent marker consisting of 3/8"x24" iron rod in a 2"x24" iron pipe, 4" below grade. I further certify that I established 4 references or witness monuments consisting of 2 fence posts, 1 tele. pole, 1 power pole, which reference or witness monuments are located in the manner following.

W 48.46 ft. Cor. Fence Post (N&B cap)
N137.69 ft. Power Pole (N&B cap)
E 37.03 ft. Cor. Fence Post (N&B cap)
SE 25.50 ft. Telephone Pole (N&B cap)

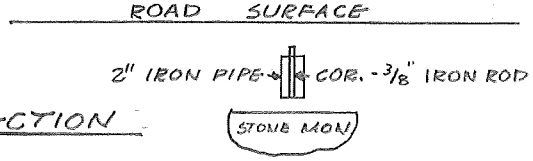

SECTION

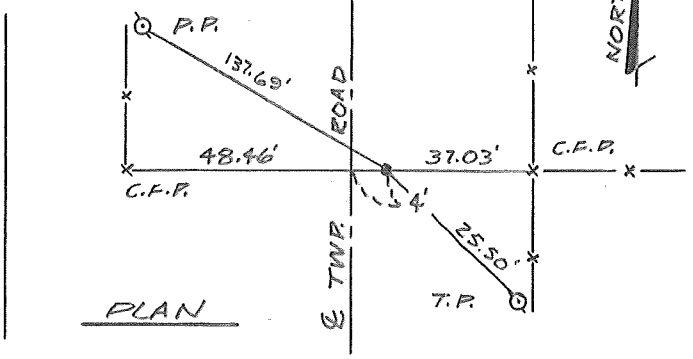

PLAN

Dated at Rochester, Minnesota, this 1st day of December, 19 66.

Distance to N1/4 Sec. 22 = 2645.65'

Leonard Sankstone

Registered Land Surveyor No. 5325

OFFICE OF THE REGISTER OF DEEDS

County of _____

I hereby certify that the within instrument was filed in this office for record on the _____ day of _____ A.D., 19____.

Office of Register of Deeds
Mower County, Minnesota
280008
I hereby certify that the within instrument was filed in this office for record on the 8 day of Dec 19 66
at 11 o'clock A.M. and was duly recorded in Book 137 Page 71 Misc
Register of Deeds
By Deputy

Register of Deeds

BOOK 25 PAGE 137

68