Index No. _____

CERTIFICATE OF LOCATION OF GOVERNMENT CORNER

Northeast Corner of Section 24, Township 104N, Range 15W, 5th P.M.

STATE OF MINNESOTA, County of Mower


At the corner location shown on the sketch:

☒ On 10-24-89 (DATE) found a 1/2" x 3 feet threaded iron rod

☐ left monument as found, ☒ lowered monument, ☐ removed monument (explain)

☒ On 10-25-89 (DATE) placed a Cast Iron Disk on Telspar Tube

SKETCH OF REFERENCE TIES

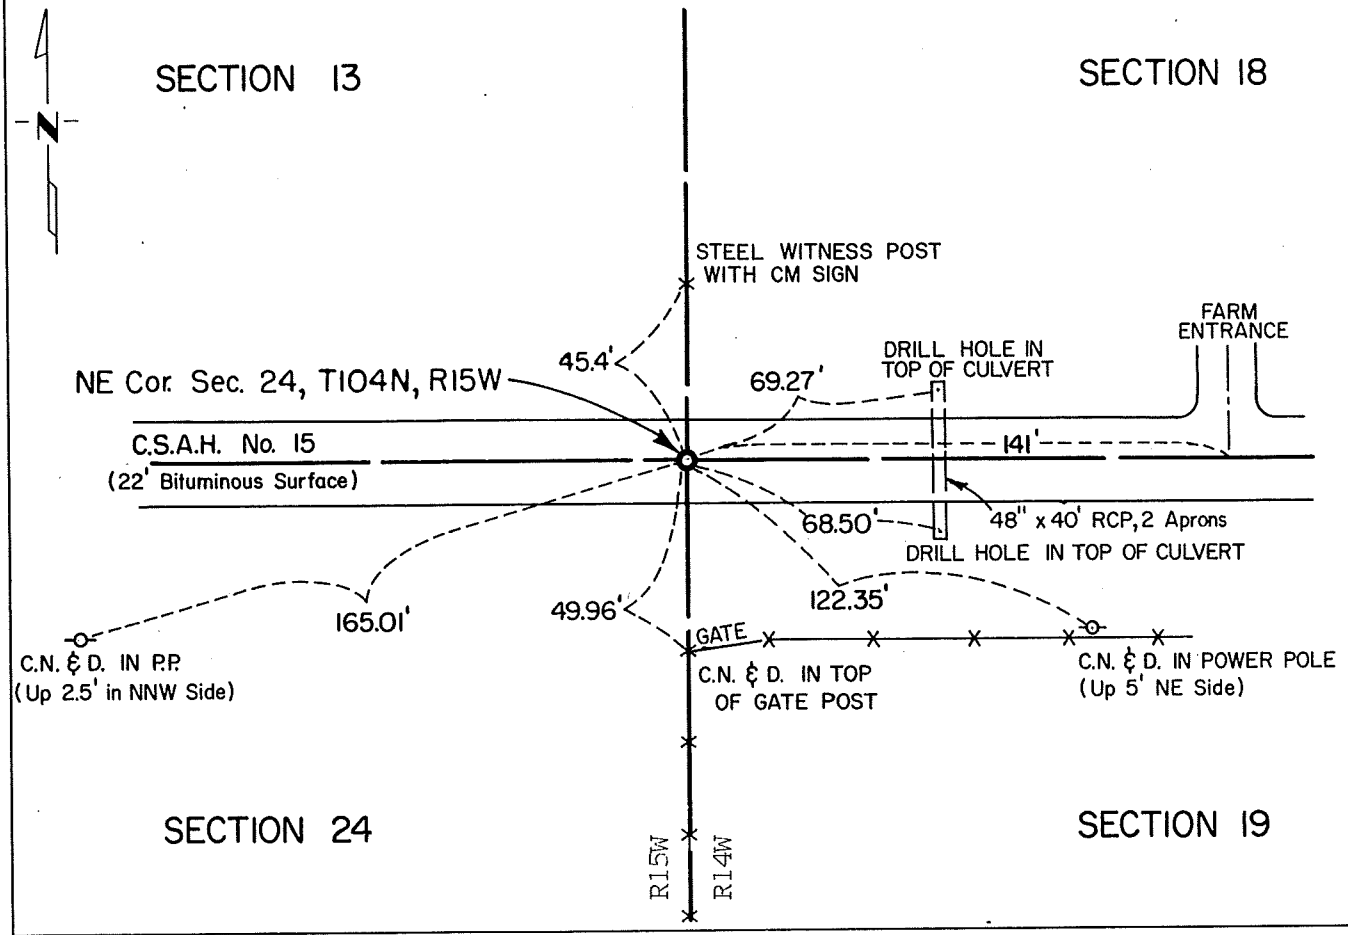

Statement of evidence relative to this corner location is on back of page.

I hereby certify that this document and the data contained herein was prepared by me or under my direct supervision.

Marlow R. McGowan 4/21/92
SIGNATURE DATE

Registration No. 11527

☒ Land Surveyor, ☒ Professional Engineer

☐ County Surveyor, ☐ County Engineer

OFFICE OF THE COUNTY RECORDER

County of Mower

I hereby certify that this document was filed in the Co. Recorders office at _____ .M. on the _____ day of _____ A.D., 19 ___

County Recorder _____

By _____, Deputy

DOCUMENT NO. _____

M.H.D. FORM NO. 2105

Statement of Evidence:

Northeast Corner Section 24, T104N, R15W, 5th P.M.

July 1853	John Bull, Deputy Surveyor, set a post and mound for the corner during the original public Land Survey.
1954	County Highway records show a concrete monument at the corner with ties to fence posts.
1968	County highway records show a 3/4 inch iron inplace 66 feet west of a culvert.
Oct. 24, 1989	Minnesota Department of Transportation excavated an area 8 feet East-West by 3 feet North-South centered on the County road plan location. A 1/2 inch by 3 foot long threaded iron rod was found.

An analysis of the record and survey data indicate that a continuous monument history is not of record. However, the 1/2 inch iron rod monuments the corner as marked for nearly 40 years. The iron rod is therefore accepted as marking the Public Land Survey Corner.

For details of the electronic survey, contact the Minnesota Department of Transportation's Surveys Section of the Rochester District Office.