BOOK 25 PAGE 140 P101 TIE BOOK

CERTIFICATE OF LOCATION OF GOVERNMENT CORNER

N 1/4 Corner to Section 35 Township 104N Range 14W No. 9


STATE OF MINNESOTA,


County of Mower _____ S.S.

I hereby certify that on the 28th day of November, 19 66, that I, Leonard Sankstone, a Registered Land Surveyor, found the North quarter corner of Section 35, T104N, R14W, which was evidenced by 8"x8"x18" sandstone monument, 36" below grade, _____ and I further certify that to perpetuate the location of such corner I did, at the exact location thereof, place a permanent marker consisting of 3"x20" cast iron ferro magnetic monument. I further certify that I established 5 references or witness monuments consisting of 2 trees, 1 GP, 1 PP, 1 FP, which reference or witness monuments are located in the manner following.

51.03 ft. 18" Boxelder (N&B cap)
37.40 ft. Power Pole (N&B cap)
51.08 ft. Guy Pole (N&B cap)
NW 49.64 ft. 42" Maple (N&B cap)
NW 100.16 ft. Flag Pole (center)

(2' S of apparent ℄ E-W County Road, approx. ℄ gravel rds. N&S)
Approx. Location

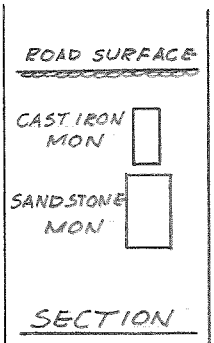

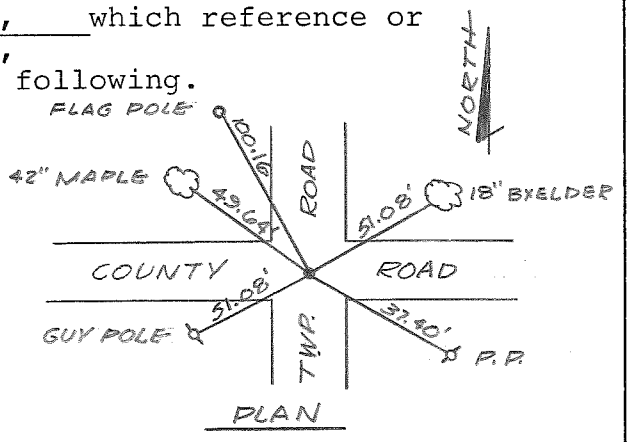

Dated at Rochester, Minnesota, this 1st day of December, 19 66.

Distance to NW cor. Sec. 35 = 2660.42
Distance to NE cor. Sec. 35 = 2632.48
Distance to Railroad = 1385.14
Distance to U.S. 63 = 1645.24

Leonard Sankstone

Leonard Sankstone

Registered Land Surveyor No. 5325

OFFICE OF THE REGISTER OF DEEDS

County of _____

I hereby certify that the within instrument was filed in this office for record on the _____ day of _____ A.D., 19____.

280011

Register of Deeds

68