W 1/4 Cor Sec 3-101-15


Cert. Filed 5-16-91 by JHS

Dug on ℄ N-5 road in line with fe E-W for CSAH #9 grading project SAP 50-609-07

uncovered a Harrison CIM 1' deep removed and dug a 6'x5'x4' deep hole and uncovered no further evidence of PLS corner, assumed CIM set by Co. Hwy Dept. mon. fits occupation and Rd ℄ and is accepted reset CIM at same location

4-24-91 DRR/RMK x 7.

60°

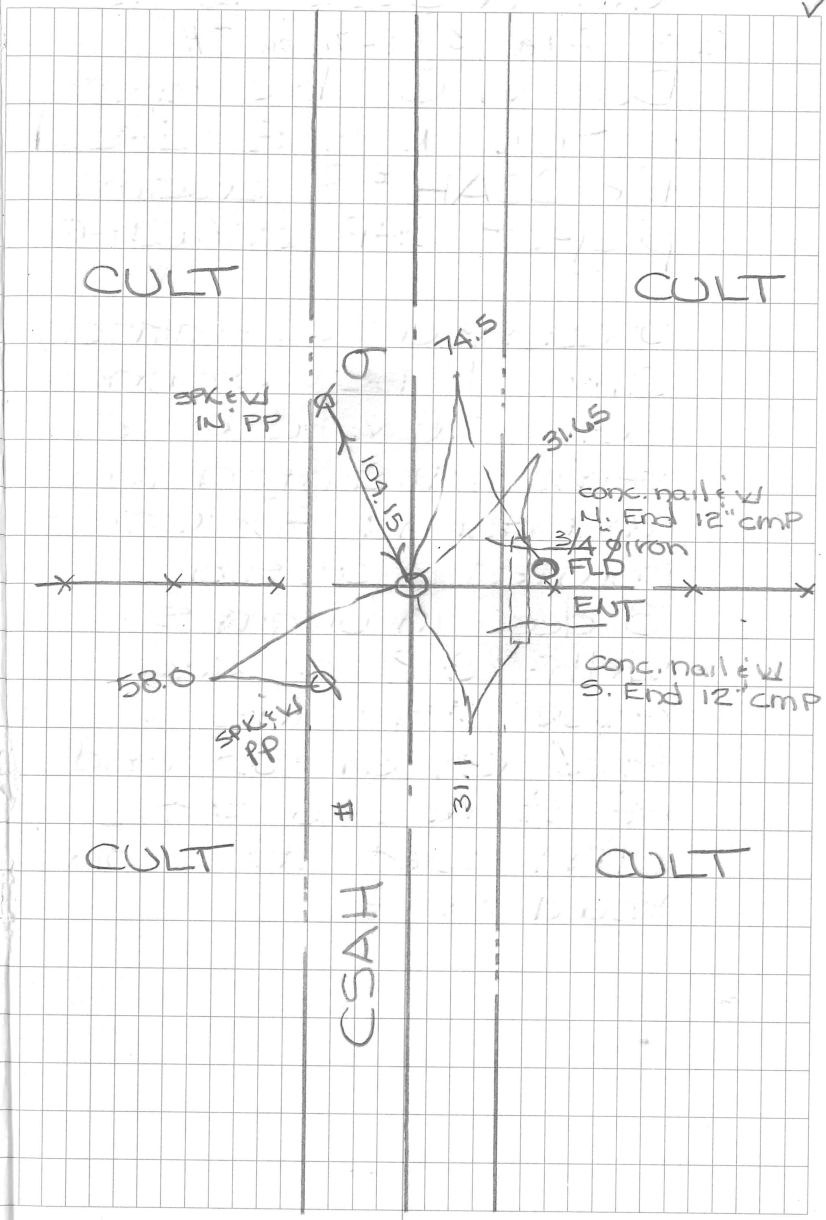

5-20-91 DRR/RMK 9
Clear 60°

Traverse on CSAH #9

⊥ @ W1/4 Cor Sec 10 (2)

SW Cor Sec 10 2638.39 (1)

PI 38+57 ∡ 180°17'04" (3)
D 1407.07

NW Cor Sec 10 (4)
∡ 180°01'55" 56"
D 2653.24

⊥ @ NW Cor Sec 10 (4)
BKST W1/4 Cor Sec 10 (2)

W1/4 Cor Sec 3 ∡ 179°27'28"
D 2627.02

PI 90+37 ∡ 179°31'19" (6)
D 3934.10

NW Cor Sec 3 (7)
∡ 179°27'16" 20"
D 5221.02

5/8" ϕ Irons W. in fe (98.13 & 214.07)

SPK & W ℄ TWP RD E. (67.87 & 189.77)

(5)