NE cor SEC. 6-101-15


NO INFORMATION FOUND IN MOWER Co. CORNER RECORDS

5-26-05 JHS CREW UNCOVERED ± IRON.

JHS CREW DEVELOPED WITH BOBCAT BROS. BACKHOE, AT POINT OF SIGNAL FROM LOCATOR. UNCOVERED ± IRON. 1½" X 1.3' CONTINUED DIGGING AND FOUND OTHER EVIDENCE OF PLS CORNER. REPLACED ± IRON AND SET 5/8" X 16" IRON WITH CAST IRON MON. OVER ± IRON FOUND .60± BELOW RD SURFACE

FOUND SPK/W IN PPS - NE & SE.

6-14-05 CLOUDY HLS MHS 52

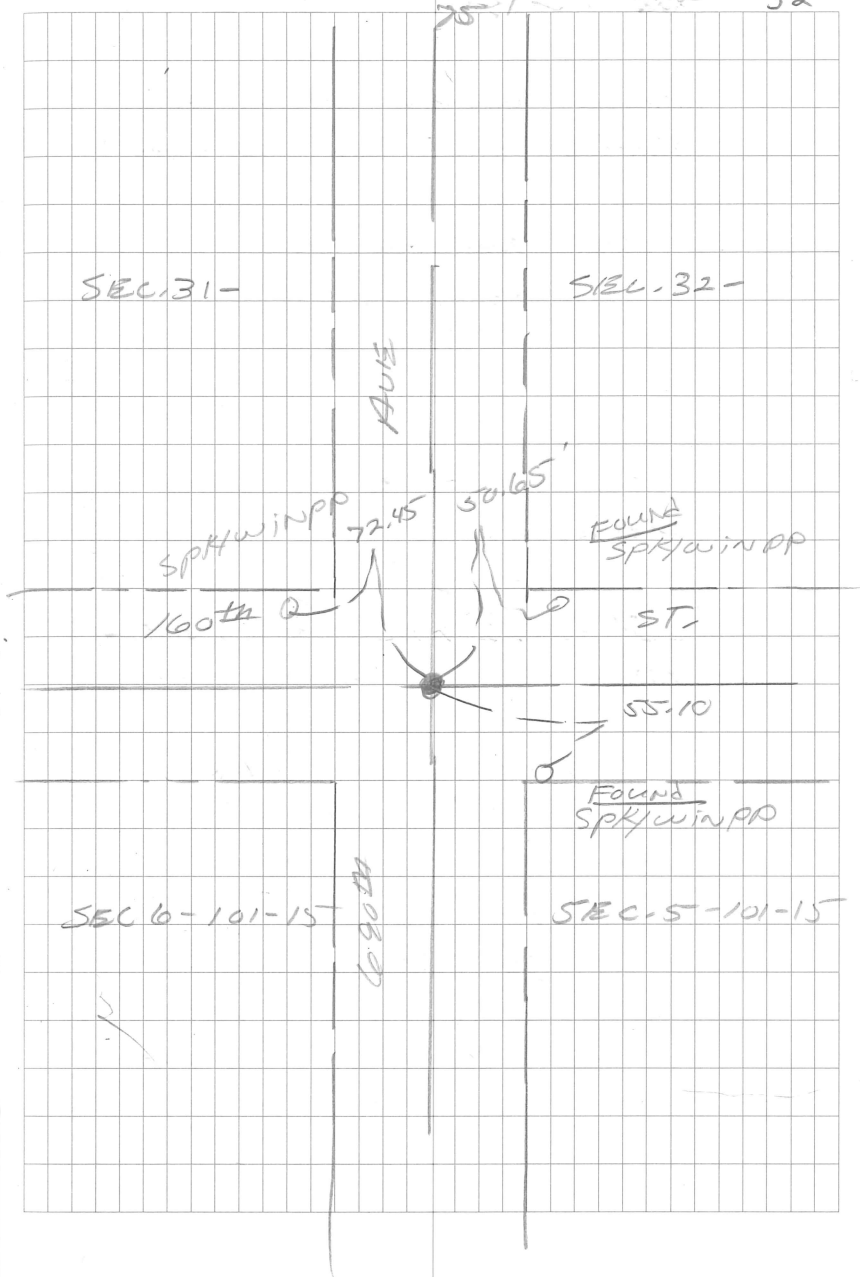

NE CO2 SEC. 6-10I-15

THIS CREW DUG BY HAND AT INTER. OF ROADS N-S-E-W AND LOCATED AN ANGLE IRON AT ROAD SURFACE. LEFT MON AS FOUND AND TIED OFF.

8-7-99 CLOUDY 70°

TRS SRG

38

