
NE Cor Sec 16-101-15
cert. Filed 5-2-91 by JHS
Dug with Co. backhoe on ℄ N-S Rd for CSAH #9 grading project SAP 50-609-07

Dug at location of 1941 ties recorded in BK "A" in Co. Eng. office

and uncovered harrison C1M 1.0' deep over a conc. monument 2' below road surface left monuments as found

4-12-04 Fence removed. Set ties as shown SJT/MHS
Fd C1M

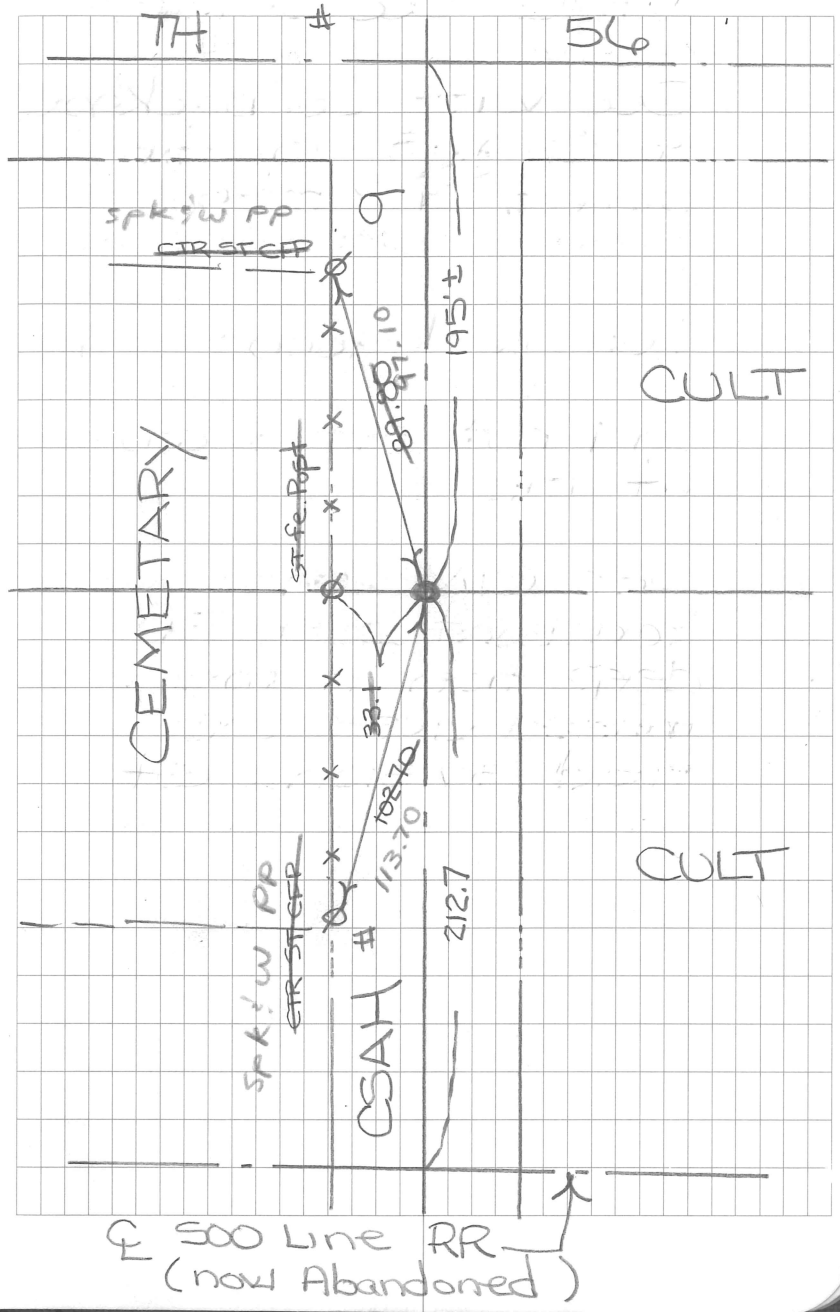

5-20-91 DRR/RMK 9
Clear 60°

Traverse on CSAH #9

⊥ @ W1/4 Cor Sec 10 (2)

SW Cor Sec 10 2638.39 (1)

PI 38+57 ∡ 180°17'04" (3)
D 1407.07

NW Cor Sec 10 (4)
∡ 180°01'55" 56"
D 2653.24

⊥ @ NW Cor Sec 10 (4)
BKST W1/4 Cor Sec 10 (2)

W1/4 Cor Sec 3 ∡ 179°27'28"
D 2627.02

PI 90+37 ∡ 179°31'19" (6)
D 3934.10

NW Cor Sec 3 (7)
∡ 179°27'16" 20"
D 5221.02

5/8" ϕ Irons W. in fe (98.13 & 214.07)

SPK & W ℄ TWP RD E. (67.87 & 189.77)

(5)