
NE Cor 17-101-15

Mower County Records show
Imp 1/2" Iron bar .6' deep
with 7/8" x 8" Bolt on Top
241' North of ℄ RR
1.0' East of ℄ TWP Road

See Book 430 pg 32
Fd Boat Spike 1.0° Deep
106' ± North of ℄ TH #56

JHS CREW dug with RAY
TRUCKER BACKHOE. At Location
of Signal from Location.
UNCOVERED 3/4" x 6" Bolt NO
TOP 3/4" IRON with SMALL
STONES AROUND IRON.
LEFT MON's AS FOUND & DUG
SET 5/8" IRON with CAST IRON
MON. OVER MON's FOUND
.60± BELOW Rd. SURFACE.

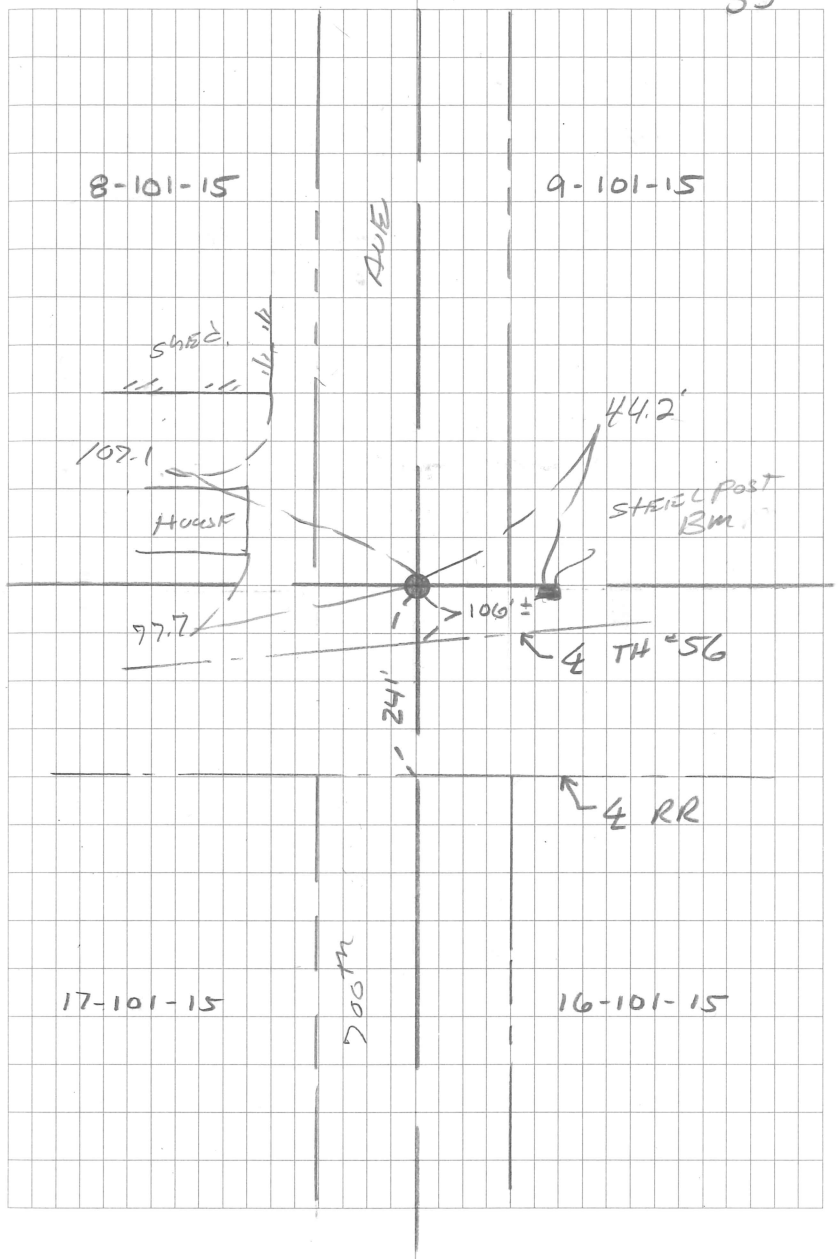

SW COR SEC. 9-101-15

JHS CREW DUG AT LOCATION OF DIP ANG LOCATED 1½" BAR 0.6' DEEP. TOOK TIES

CLOUDY 8-7-7°
70°

TIES ORG

