NE Cor 18-101-15

Mower County Records show
Nail + Disc in Cross Planking
PP NE 45.0
PP SE 64.31
TP SW 40.97
Corner being
2' N of ℄ Tracts
591.5' W of RR signal
0.36 S of gage of N rail


Hwy R/W Plan 56 shows corner
101.4' South of ℄ HWY

CMS+P+P RR Plan shows corner
2' North ℄ RR

JHS COMPUTED LOCATION OF COR
2.0' N. OF ℄ RR ⊃ ℄ OF 80°25'
FROM TH 56 HWY STA 137+72.6 THIS
LOCATION FITS GRAPHICALLY WITH
WHAT IS SHOWN OLD HWY PLAN &
ALSO MAKES 50.1/2 MILES OR
SEC 8 NEARLY =. AS SHOWN ON
SKETCH & FITS MEAS DIST
BY LINDSAY ENG. IN 1965 WHO
HAD LOCATED THE COR FOR SUB STA

5-6-06 JHS

55

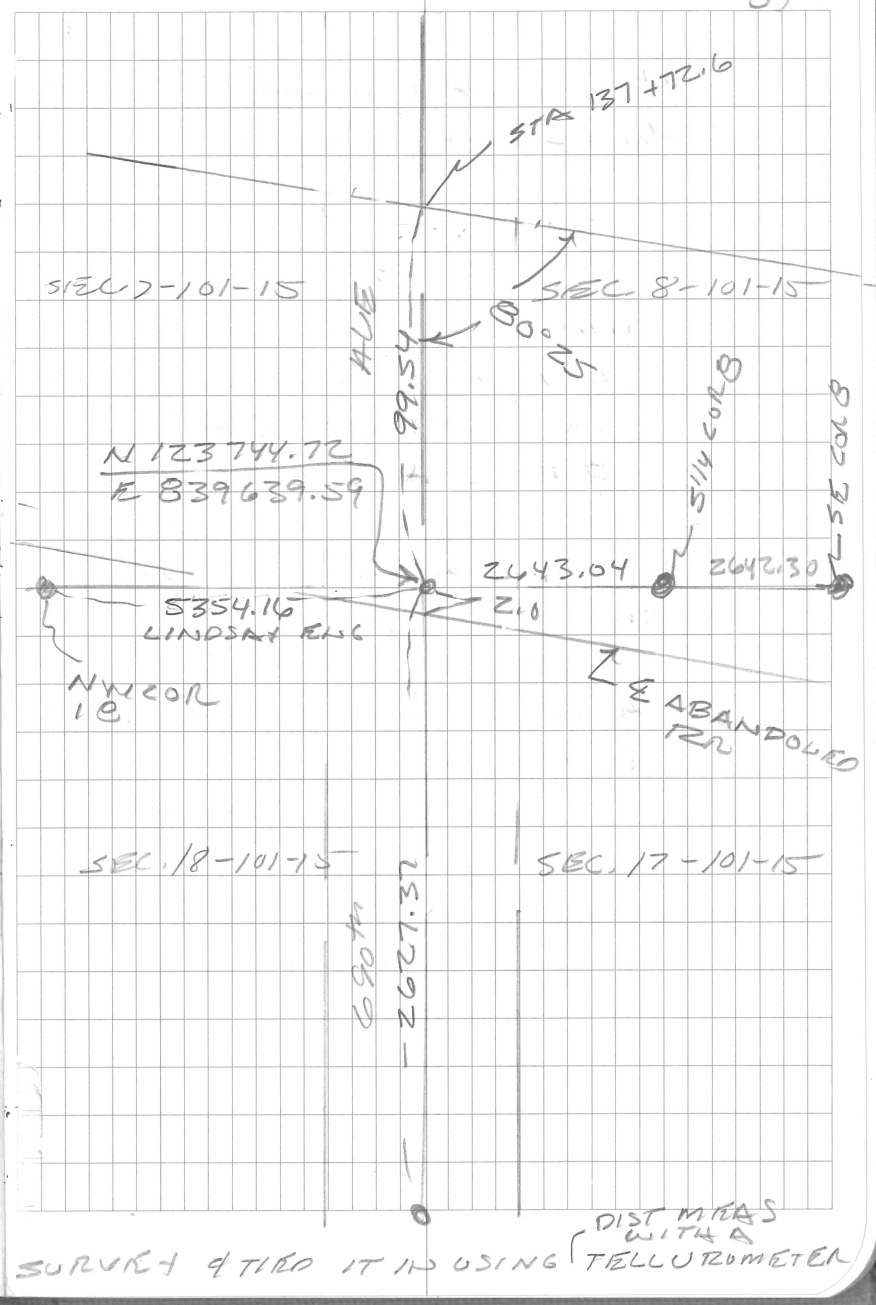

SURVEY & TIED IT IN USING