SE cor SEC. 31-101-15


JHS CREW Dug with
RAY TUCKER BACKHOE
UNCOUPLED 5/8" ø 25' Long

6-8-06
Cloudy.
80

HLS
MDH

25

SEC 33-101-15

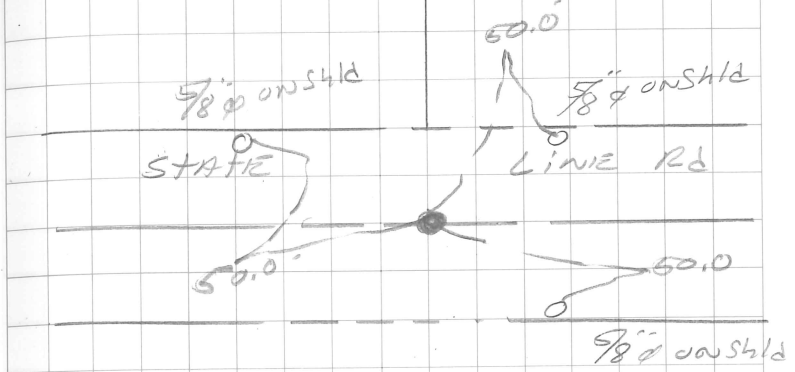

MITCHELL Co.
IOWA