
SE COR SEC-31-101-15

JHS CREW Dug with RAY TUCKER BACKHOE.
- UNCOVERED ± 3/4" ø . 80' BELOW Rd surface, LEFT MON AS FOUND, SET 5/8" X 16" IRON with CAST IRON MON. - OVER . 60' BELOW Rd. SURFACE.

6-8-06 HRS
Cloudy MDH 24
80°

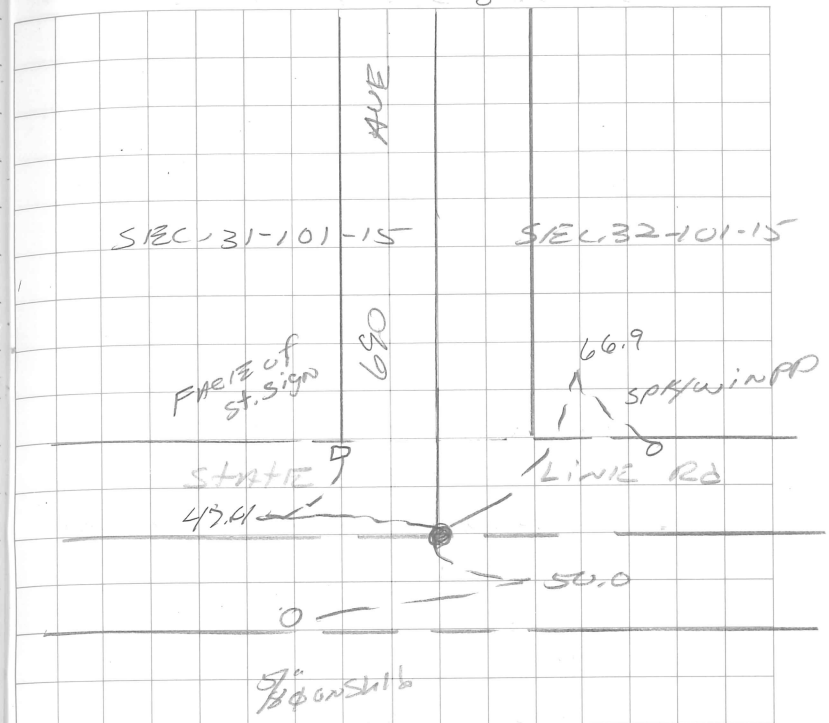

Mitchell Co.
Iowa