
6-8-06 Cloudy 80° HLS MDH 23

SE COR SEC 32-101-15

THIS CREW FOUND 2 LARGE CULVERTS AT THIS POINT. . . .
1-LARGE CMP - 1-LARGE PLASTIC CULVERTS
WORK WOULD HAVE BEEN DESTROYED AT TIME OF CONST.

EJM Set corner @ a midpoint on a straight line between SW + SE corners of Section 32-101-15. Position fits N-S fence running from N'ly corner of section through the center of section.

6/26/06 Set CIM SAT/MDH

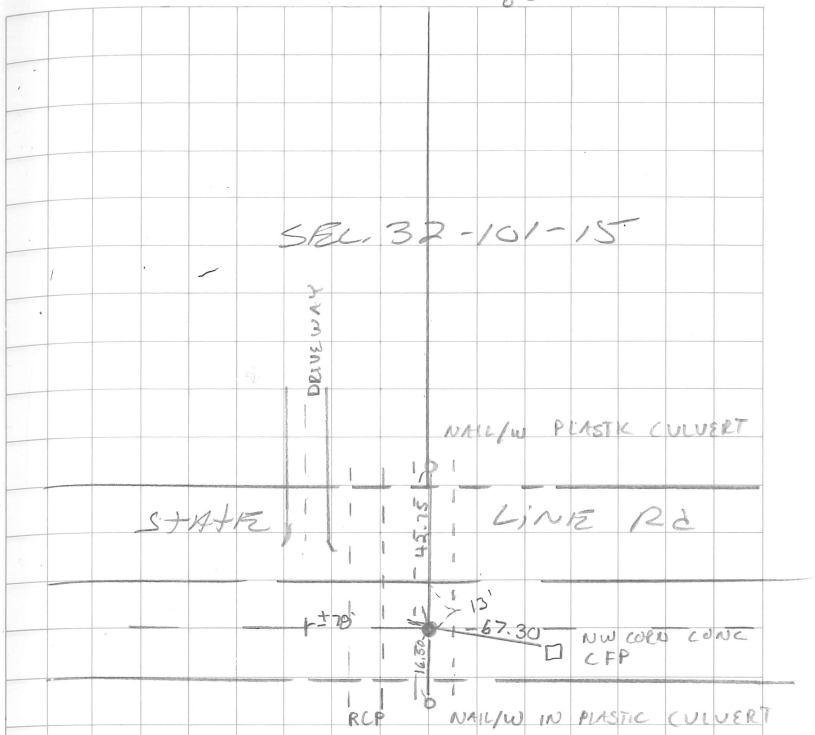

Mitchell Co.
IOWA