SE cor SEC 32-101-15


MN-IOWA STATE LINE

Dug and could not find
set 5/8" Rod for corner
this corner P.O.T between
IA. SEC COR to the west and
IO. 1/4 corner to the East

JHS crew Dug with
Ray Tucker Backhoe
Uncovered Twisted Rod
.50± Below Rd surface.
Left Rod in place,
Lowered Rod, set 5/8" x 16"
Iron with Cast Iron
mon. cover
.60± Below Rd
surface.

6-8-06
Cloudy
80°

HKS
MOH 22

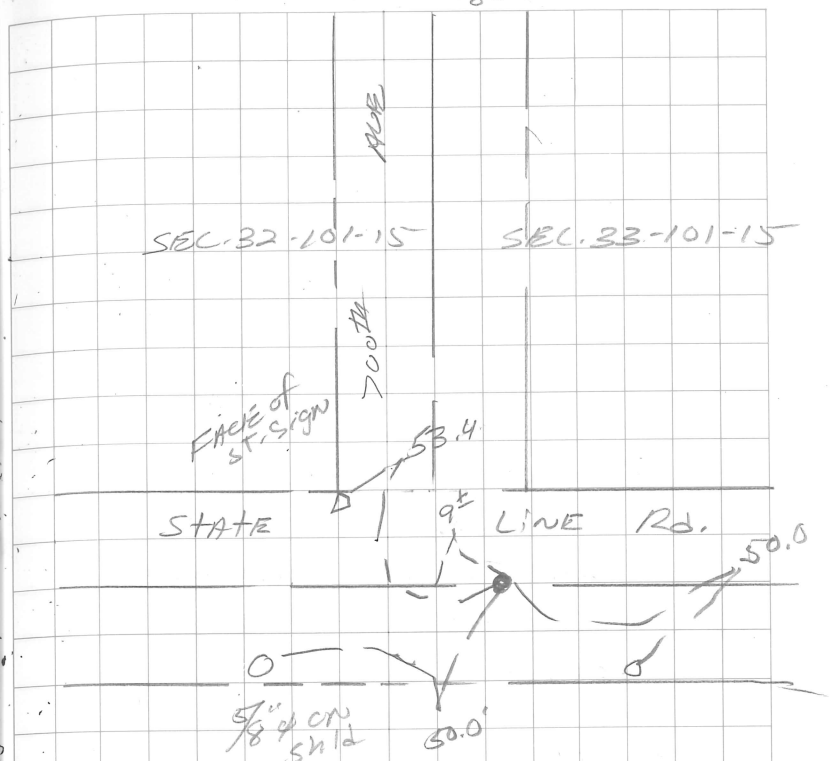

Mitchell Co.
Iowa