
6-8-06
Cloudy
HLS
MDH
21

Stk cor SEC. 33-101-15

JHS CREW Day with
Ray Tucker BACKHOE
UNCOVERED 5/8" ø, .40± BELOW ROAD SURFACE.
REMOVED 5/8" ø AND CONTINUED DIGGING.
UNCOVERED 1.2/1 x 2 1/4 IRON 2'± DEEP. LEFT 1 1/4 x 2 1/4 IRON INP.
SET 5/8" x 16" IRON with CAST IRON OVER MON. FOUND .60± BELOW RD SURFACE.

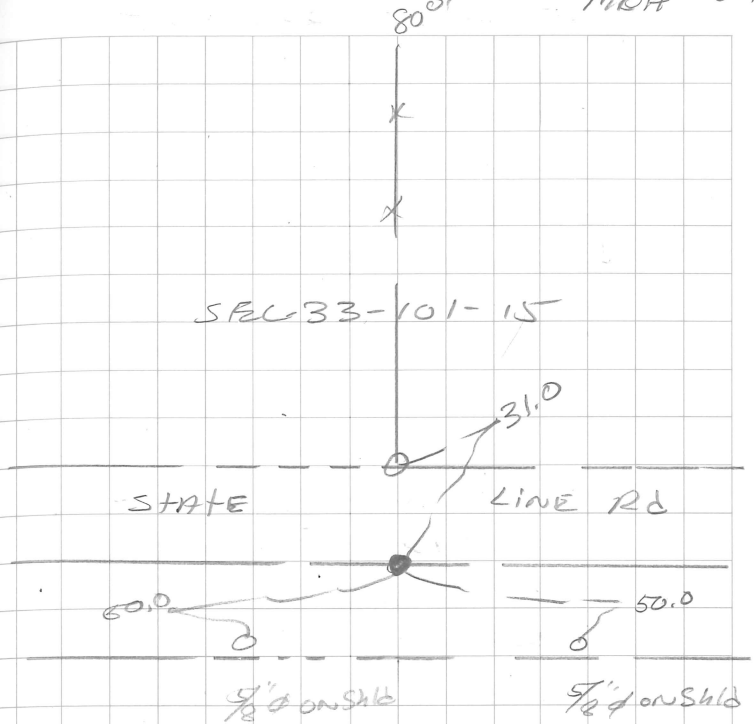

mitchell Co.
IOWA