
St Cor SEC-34-101-15

9-3-35 MN-IOWA STATE LINE
Found Hub STAKE ON LINE
with FENCE NORTH
ORDER 5/8" ø Rod 0.1' EAST
of STAKE.

JHS CREW Dug with
RAY TUCKER BACKHOE
UNCOVERED 5/8" ø -60± BELOW Rd SURFACE.
LOWERED 5/8" ø AND
SET 5/8" x 16" IRON OUTER
5/8" ø Found.
-60± BELOW Rd
SURFACE.

6-8-06 HLS 19
Cloudy MOH
80ø

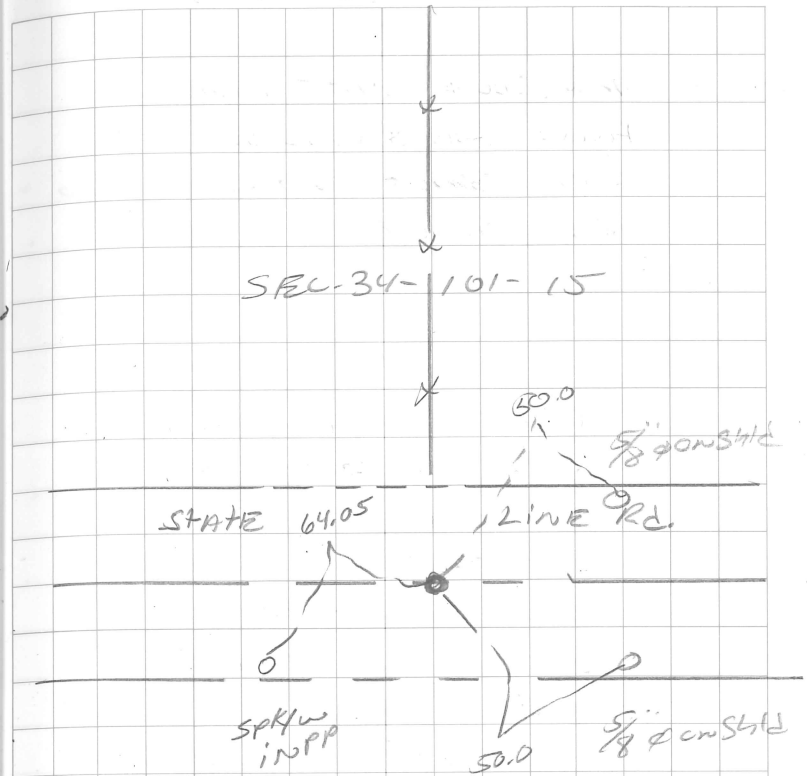

Mitchell Co.
IOWA