
6-8-06 Cloudy 80° HHS MDH 17

Sty Cor SEC 35 – 101 – 15

9-8-30 MN. & Iowa State Line
Found HH on end with
piece of Flat Stake over
H-P.
SEE COR. CERT BY LEE GALLENTINE
Iowa RLS 15745 (MAR 18TH 2005

JHS crew Dug with
Ray Tucker Backhoe
Uncovered Pointed
Stone. with a Plastic
case – with 1" Magnetic
Rod. on North side
of Stone.
Left Mon's as Found
And set 5/8" x 16" Iron
with Cast Iron Mon. over
Mon's Found
.60± Below Rd.
surface.

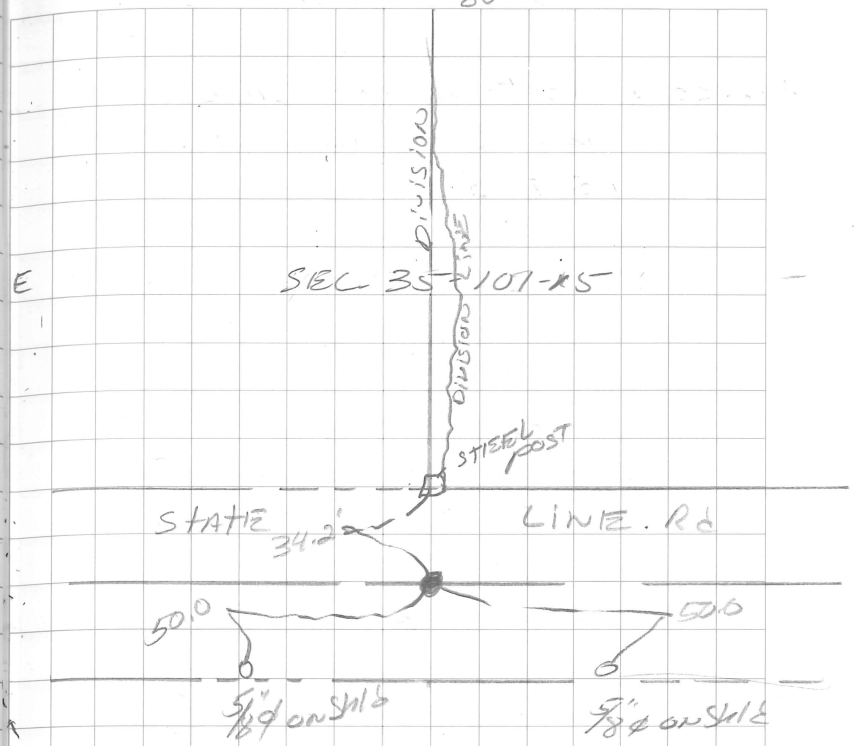

Mitchell Co.
Iowa