10-13-92

18


S1/4 Cor Sec 36-102-16

cert. Filed 12-16-92 by JHS

Dug a 10'x10'x7' deep hole and found nothing

1322.60
x2
2645.20

"Note" SEE pg. 19

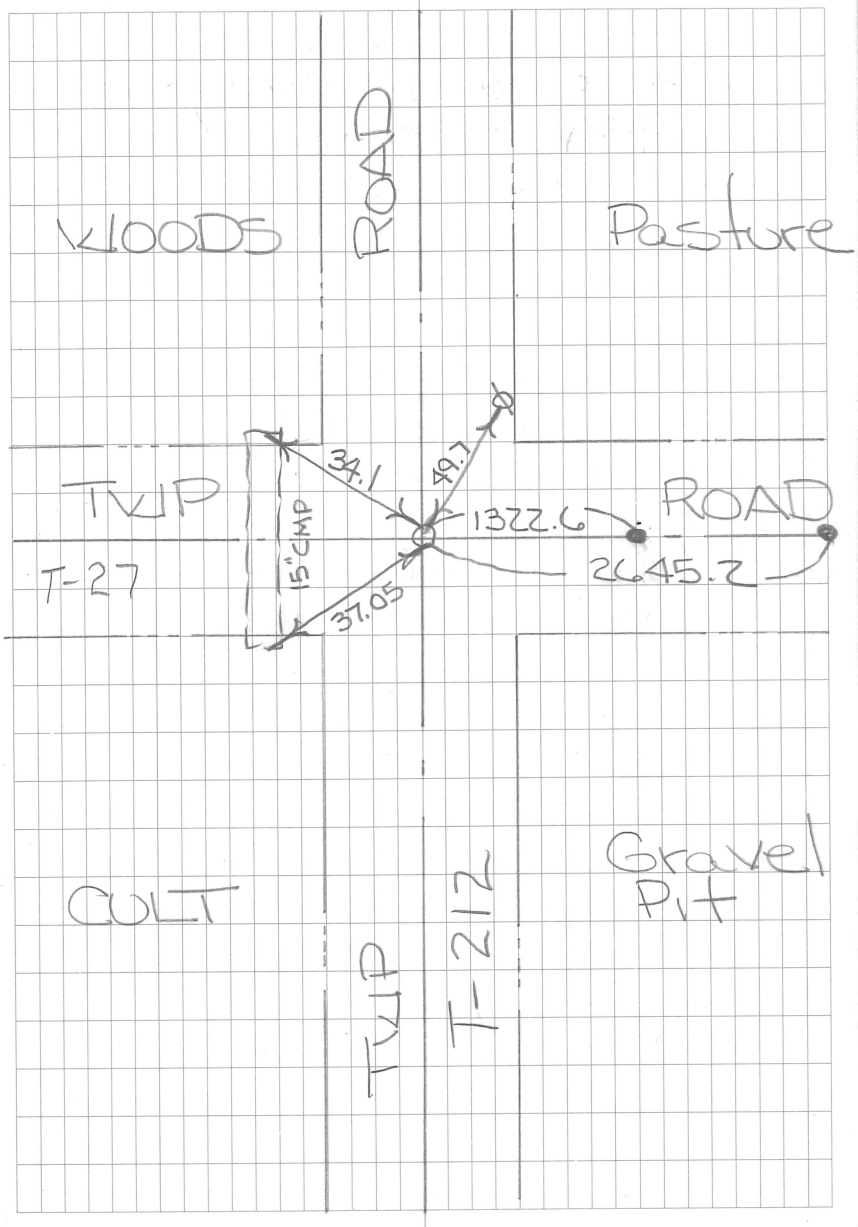

SW Cor SE¼ SE¼
Sec 36-102-16

1954 records show a conc. mon was placed for survey of Co. Pit Dog in line with fence north and using a tie of 33.6 SSE to Red oak Dog a 6' x 8' x 8' deep hole and found nothing

SET ¾ ϕ iron using ties

"Note" SEE pg. 18

