
NE cor SEC. 2-101-16

County road No 7 road plan 1952/1954
Shows Inp Conc Mon 12" below surface. 45.° NE to PP - 73.5' NE to 3" Pipe Gate Post - 119.9' SW to TP

7-15-05 VHS CREW DUG IN THIS LOCATION WITH BACKHOE & FOUND NO EVIDENCE OF COLC MON COMPUTED LOCATION OF COR FROM CO. ROAD PLAN NO MON SET THIS TIME

7-15-05
CLEAR
HLS
MHS

90+

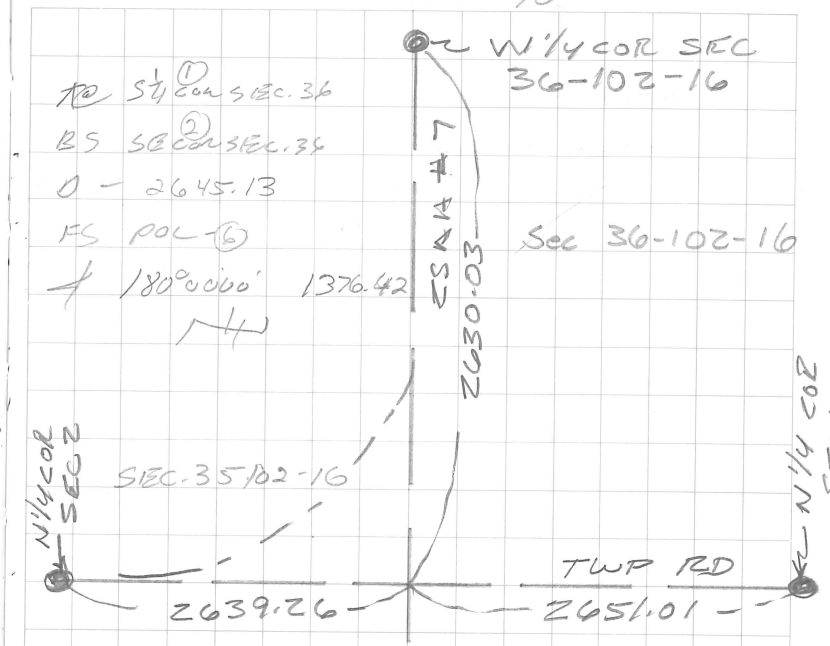

@ S 1/4 ① Con SEC. 36
BS SEC ② SEC. 36
D - 2645.13
FS POL ⑥
+ 180°00'00" 1376.42

@ POL ⑥
BS PT ①
D 1376.42
FS PT ⑦ 3 1/4"
+ 179°57'36" D-3913.65 FS 1313.85 Cal (2.73 Left)
FS PT 4
+ 180°00'00" D 3.
FS PT 3
180°00'00" D-1272.54
SEC. 2-101-16

Sec 1-101-16