
W¼ cor SEC. 9 - 101 - 16

1951 MOWER CO. RECORDS STATE INP CONC. MONI.

JHS CREW dug with MOWER CO. BACKHOE ON ℄ of CSAH No. 5 AND 5.0' ± south of LINE FENCE WEST ± Dug a 3' x 7' HOLE UNCOVERED CONC. MON. with IRON pin IN CENTER @ 2.5± DEEP SET CAPPED 5/8" ℄ ON WEST SIDE. CAP No. 13807 SET 5/8" x 16" IRON with CAST IRON MON COVER MON. FOUND @ ROAD SURFACE.

9/13/12 MDH Set Survey Marker Flush.
Set ② Magnails as ties on fogline to NW & NE @ 50'. Tie to SW good.

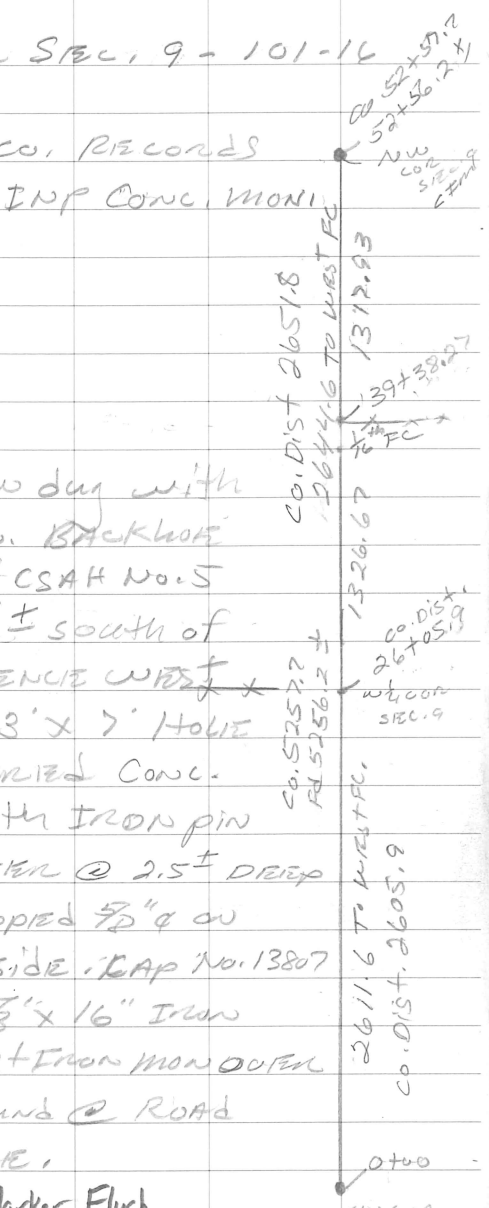

4-10-CO Cloudy; snow 35° HLS MLG

44

