
N 1/4 cor Sec 9 - 101-16

CERT FILED BY JHS 7-10-97


Set per DOT R/W Map

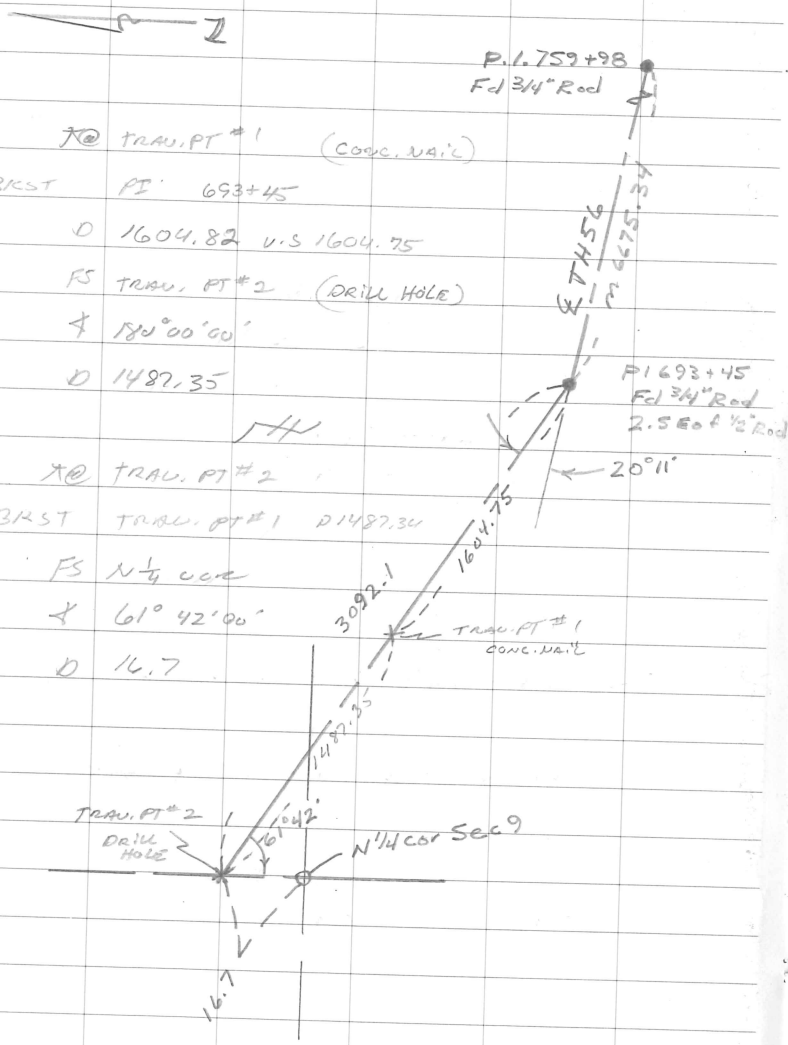

℄ @	TRAV. PT #1 (CONC. NAIL)
BRST	PI 693+45
D	1604.82 U.S 1604.75
FS	TRAV. PT #2 (DRILL HOLE)
∠	180°00'00"
D	1487.35
℄ @	TRAV. PT #2
BRST	TRAV. PT #1 D 1487.34
FS	N 1/4 cor
∠	61° 42'00"
D	16.7

5-16-96 OVERCAST 65 HLS ADM

22

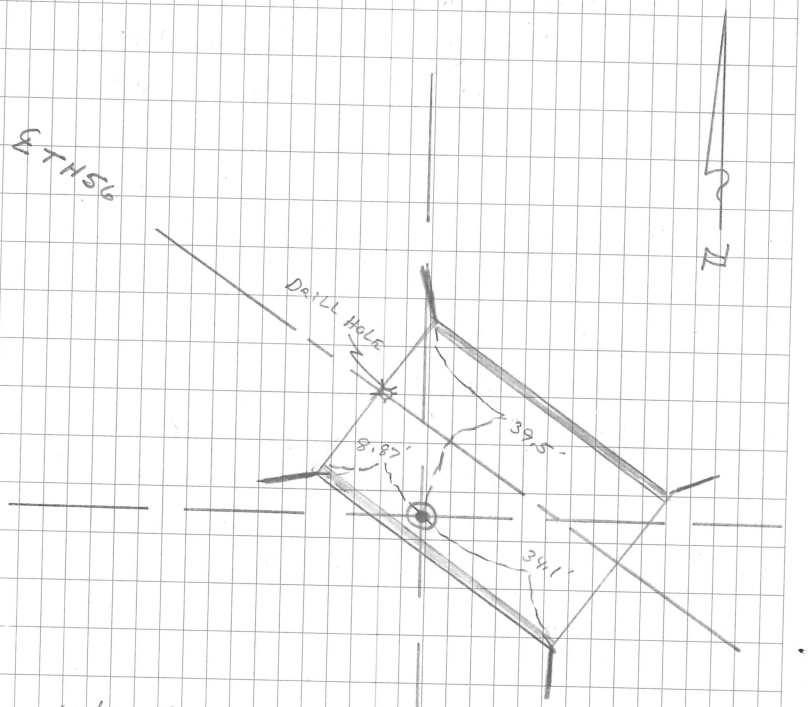

NOTE - SEE BOOK 429 - pg 16-17

Set CAPPED 5/8 Ø (No. 13807) IN Bridge DECK.

TIES. 8.87' W. to NW cor of Wheel Guard
34.1' E. to NE cor of Wheel Guard
39.5' N. to SW cor of Wheel Guard.