SE Cor SEC. 22-101-16


NO Information Found in Mower County Records.

HLS-TLM 8-6-03 Rising Corner — Found Nothing. Set corner by using FENCE LINE N & S. & E-W.

Set 5/8" X 16" Iron with CAST IRON MON. OVER.

9-30-96 JHS CREW Dug with Mower Co. BACKHOE ON & of Twp Road E-W & Twp Road N-S, Dug a 3' x 10' hole 4.5' DEEP to Virgin Soil, Found NO EVIDENCE of PLS CORNER.

Cor should be 11' - 4' N of E&E may have to dig further N

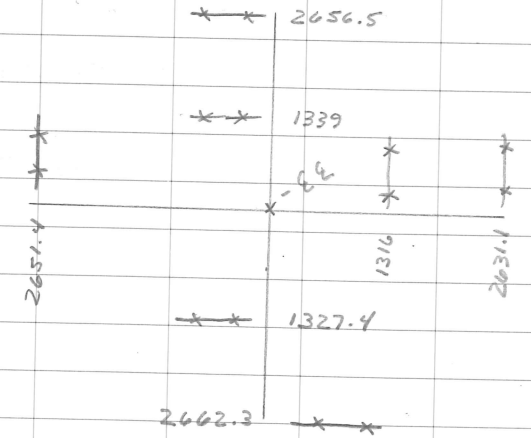

9-20-96 cloudy HLS JPA

25

