
3-25-88 DRR
Cloudy-windy RMK 54
40°

S1/4 Cor Sec 19-101-16

Found no evidce of PLS Corner or a perpetuation of set 5/8"ϕ iron on straight line between sec corners at a porportional part,
℄ E-W road 6'N.
15' E. ℄ Drwy N.
SPK & W Gate Post So. 27.25
SPK & W Gate Post ϕ S W 39.50
W. END 12"CMP NW 48.75

SEE Book - 334 pg 23

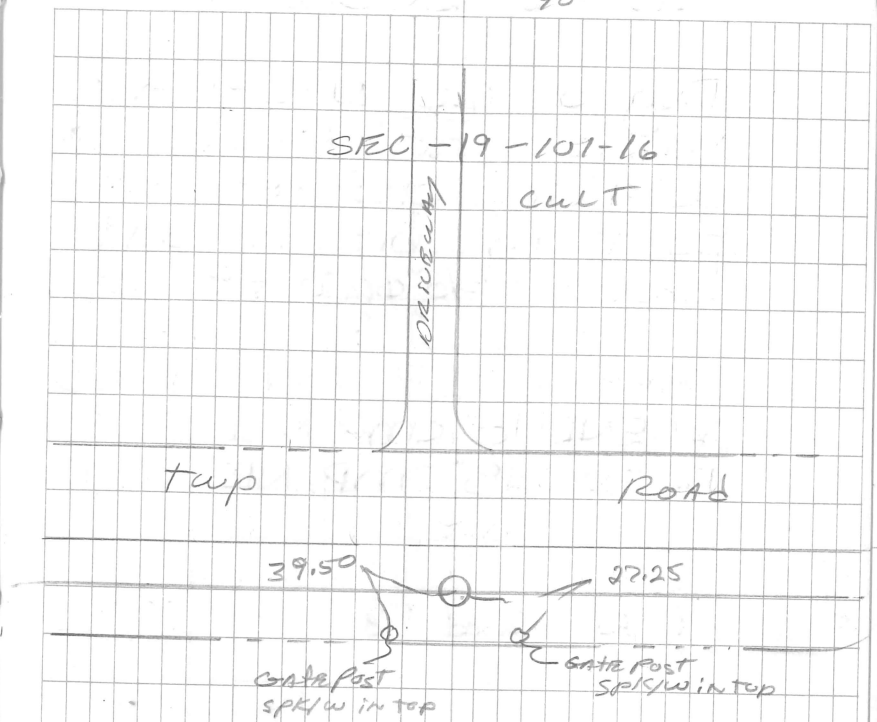

SEC. 30 - 101 - 16
CULT

4-14-88 HLS & MLG
SET CFM OURN 5/8"ϕ FOUND
CMP 13807