8-01-02 Cloudy 90°F HLS SAT


S½ cor SEC-31-101-16

No Information Found in Mower Co. Corner Records

JHS CREW Dug with Mower Co. BACKHOE. Dug 6' x 12' Hole Down to Virgin Soil, 6.73 Chains East of Iowa Line Fence South and Found No Evidence of PLS corner, Have No Line Fence on Field Division North

Set Corner at a split of Straight Line between SE & SW Corners. Set 5/8" x 16 Iron with Aluminum Mon.

move 2.5ft West

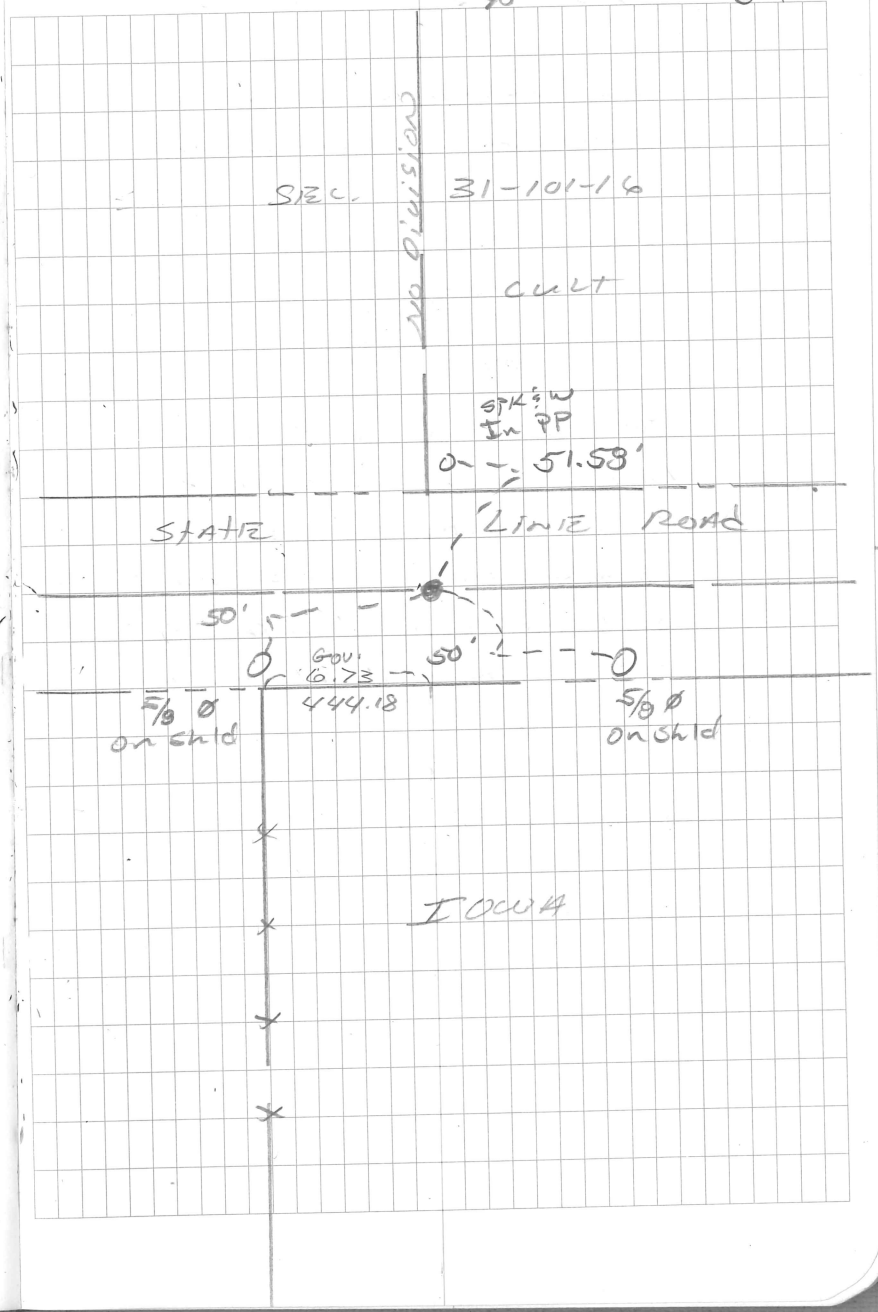

ADAMS Twp - South Line

SEC.'S 31 & 32

BS	① POL		⊙ spk/w
	④ SW cor SEC. 31		Fd ctm
D	3143.73		
FS	⑤	Iowa cor	Fd spk/w
∠	00°00'00"	3585.73	
FS	③ PC Line South Iowa		
∠	00°00'00"	941.48	
FS	② S¼ cor SEC. 31		⊙ spk/w
∠	00°00'00"	490.14	451.34
FS	⑥	Iowa cor	Fd ½" ø
∠	179°54'43"	1717.81	
FS	SE ⑦ cor SEC. 31		Fd ctm
∠	180°00'00"	2160.92	
FS	⑧ S¼ cor SEC. 32 on C&R Rd.		⊙ spk/w
∠	180°00'00"	4810.27	
FS	⑨ SE cor SEC. 32		Fd ctm
∠	180°01'42"	7463.98	

NH

8-14-02 Cloudy 75° HLS

59

