SW COR SEC. 32-101-16

No Information Found in Mowtin Co. Corner Records

Gov. Notes - 6.73 Chains East of SEC. 12-100-17 (Iowa)


JHS Crew dug with Mowtin Co. Backhoe, on ℄ E-W Rd. and ℄ Rd North. Uncovered Rock with Iron on North side, 2.0'± East of ℄ Twp Rd North. on ℄ of State Line Rd. 3.5'± Deep.

Placed Cap. 13807 on Iron. Set 5/8" x 16" Iron with Cast Iron Mon. .60± Below Rd Surface

8-01-02
Cloudy
80

HLS
SAT

55

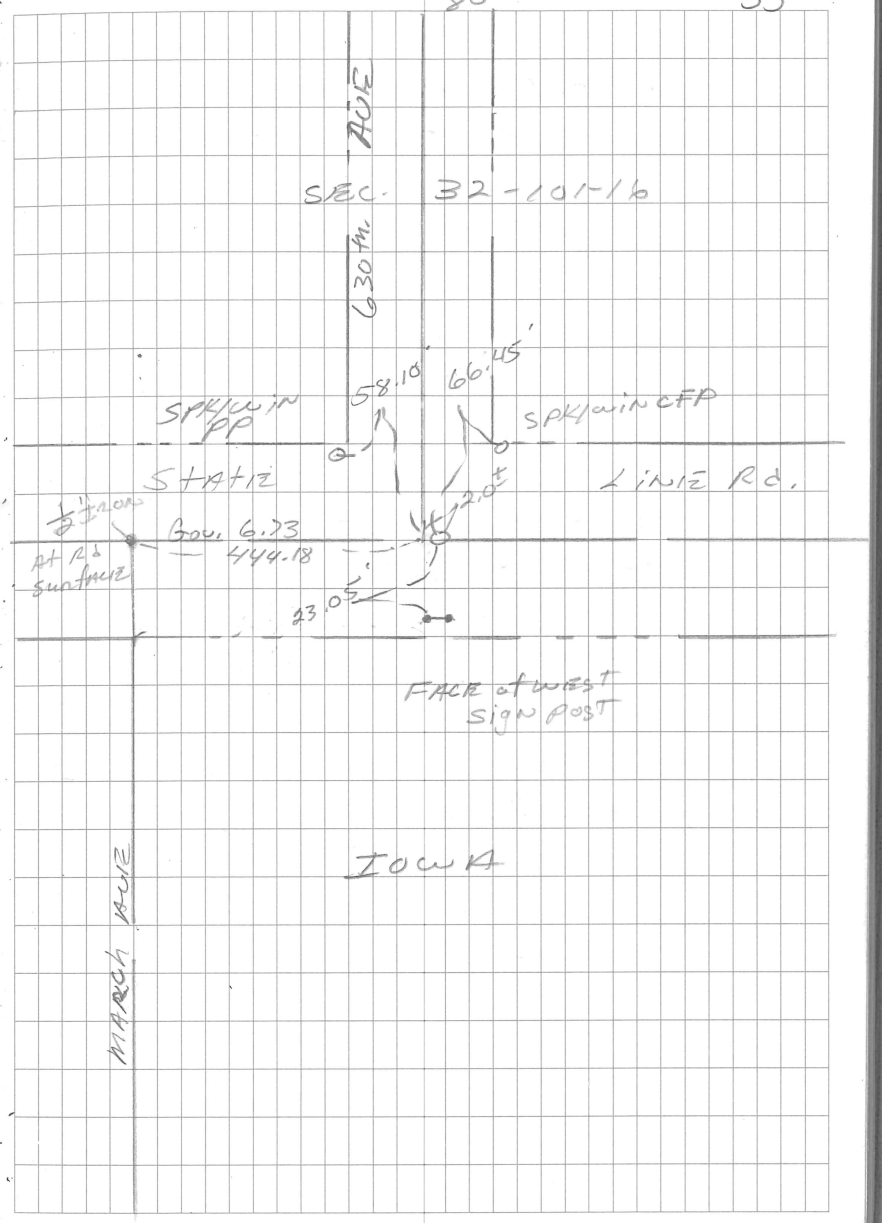

ADAMS Twp - South Line

SEC.'S 31 & 32

BS	① POL		⊙ spk/w
	④ SW cor SEC. 31		Fd ctm
D	3143.73		
FS	⑤	Iowa cor	Fd spk/w
∠	00°00'00"	3585.73	
FS	③ PC Line South Iowa		
∠	00°00'00"	941.48	
FS	② S¼ cor SEC. 31		⊙ spk/w
∠	00°00'00"	490.14	451.34
FS	⑥	Iowa cor	Fd ½" ø
∠	179°54'43"	1717.81	
FS	SE ⑦ cor SEC. 31		Fd ctm
∠	180°00'00"	2160.92	
FS	⑧ S¼ cor SEC. 32 on C&R Rd.		⊙ spk/w
∠	180°00'00"	4810.27	
FS	⑨ SE cor SEC. 32		Fd ctm
∠	180°01'42"	7463.98	

NH

8-14-02 Cloudy 75° HLS

59

