



NEED to SET

1/11/06 Set CIM

See Book 2 pg 34

8-01-02 Cloudy 80° HLS SMT

56

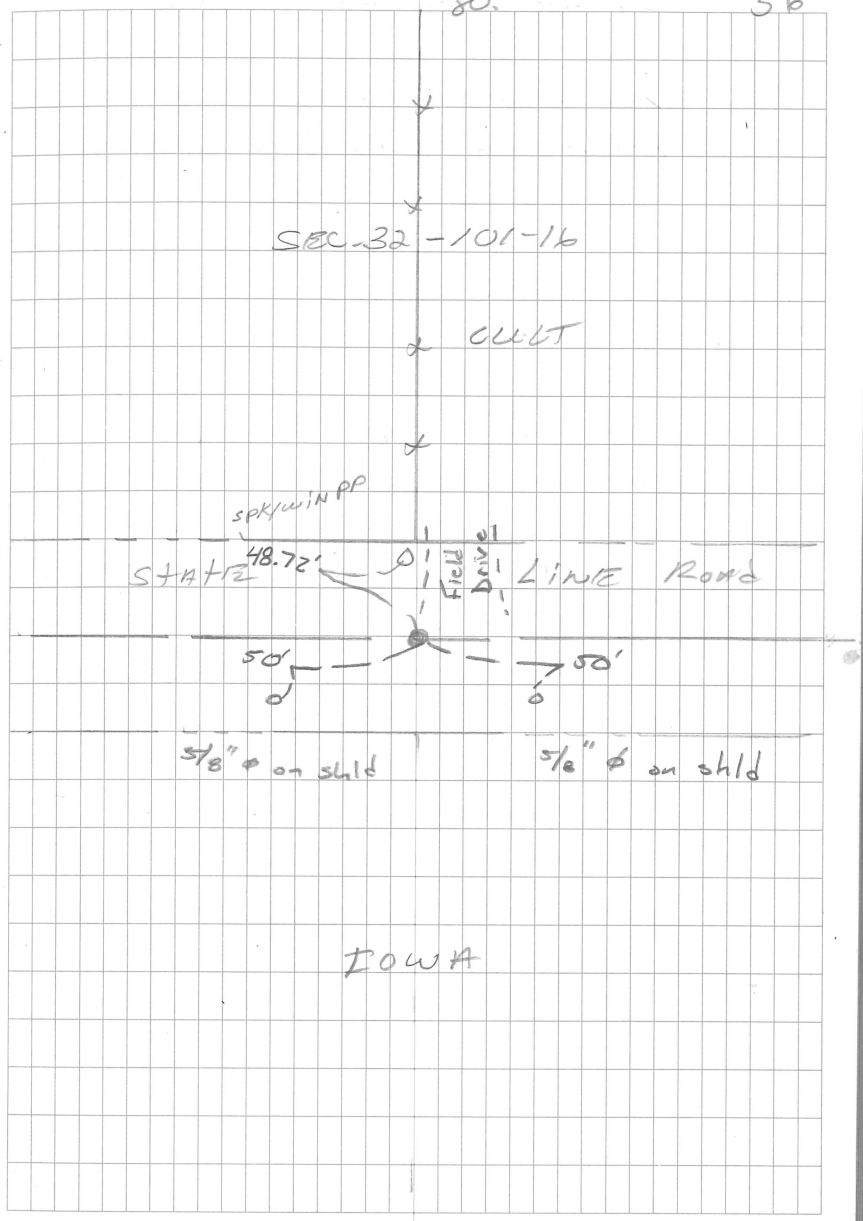

ADAMS Twp - South Line


SEC.'S 31 & 32

BS	① POL		⊙ spk/w
	④ SW cor SEC. 31		Fd ctm
D	3143.73		
FS	⑤	Iowa cor	Fd spk/w
∠	00°00'00"	3585.73	
FS	③ PC Line South Iowa		
∠	00°00'00"	941.48	
FS	② S¼ cor SEC. 31		⊙ spk/w
∠	00°00'00"	490.14	451.34
FS	⑥	Iowa cor	Fd ½" ø
∠	179°54'43"	1717.81	
FS	SE ⑦ cor SEC. 31		Fd ctm
∠	180°00'00"	2160.92	
FS	⑧ S¼ cor SEC. 32 on C&R Rd.		⊙ spk/w
∠	180°00'00"	4810.27	
FS	⑨ SE cor SEC. 32		Fd ctm
∠	180°01'42"	7463.98	

NH

8-14-02 Cloudy 75° HLS

59

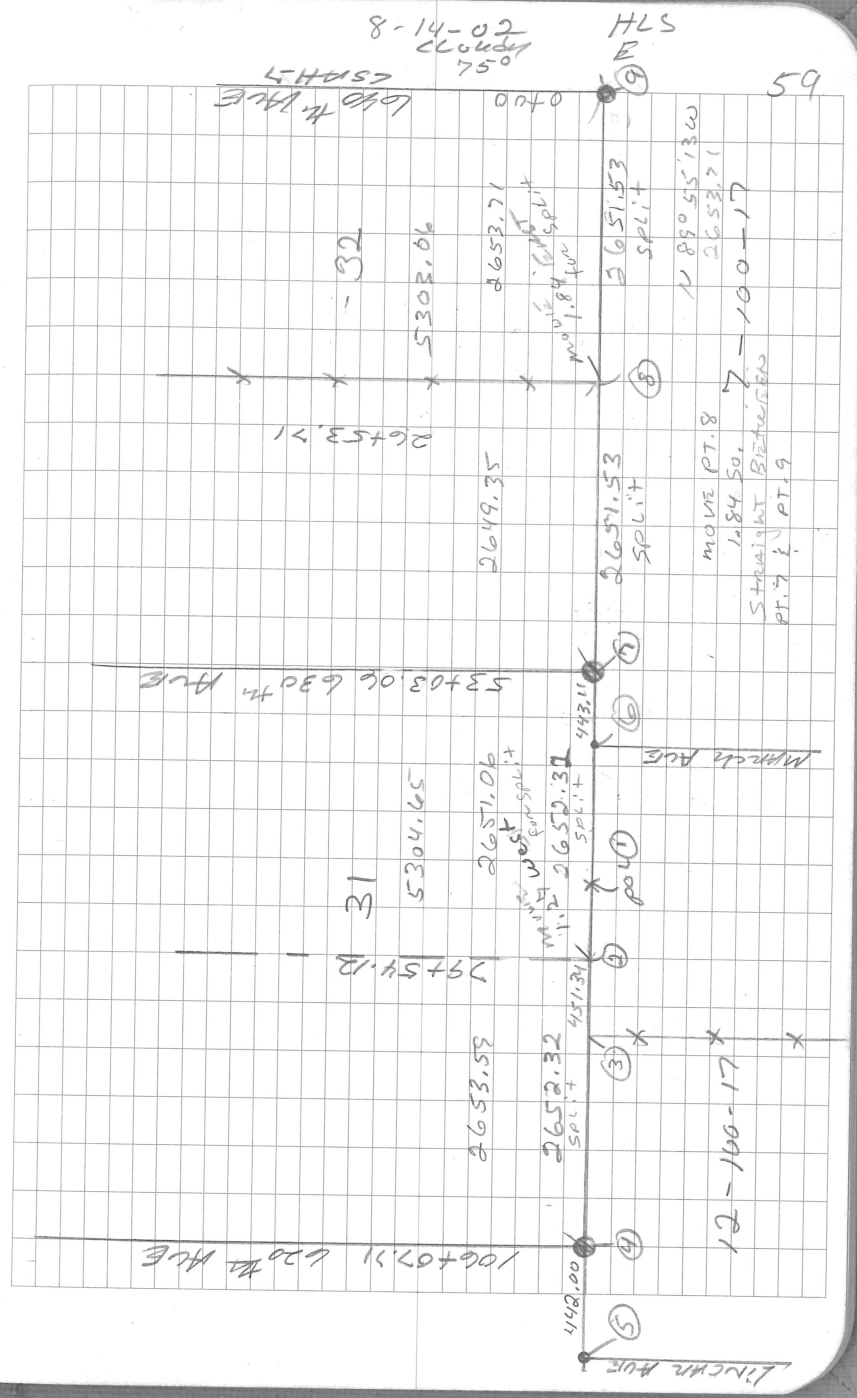

6-1-05
Cloudy
>0°
HLS
MHS
34

Stk on SEC. 32-101-16

NO INFORMATION FOUND IN MOWER CO. CORNER RECORDS.

JHS CREW dug with BOE BROS. BACKHOE ON ℄ E-W ROAD AND IN LINE with LINE FENCE North.

Dug down to virgin soil AND FOUND NO EVIDENCE of PLS CORNER.

COMPUTED POSITION ⊃ STRAIGHT LINE BET SEC COR'S ⊃ MID POINT.
NO MON SET

1/11/05 Set CIM

