
SE COR. SEC. 32-101-16

* "NEED TO DIG"

MICRO ROAD PLAN SHOW
MYLAR PLACE PLAN ROD.

JHS CREW DUG BY HAND
AND LOCATED A WITCH AT
ROAD SURFACE

7-19-99 TRS SEC 38

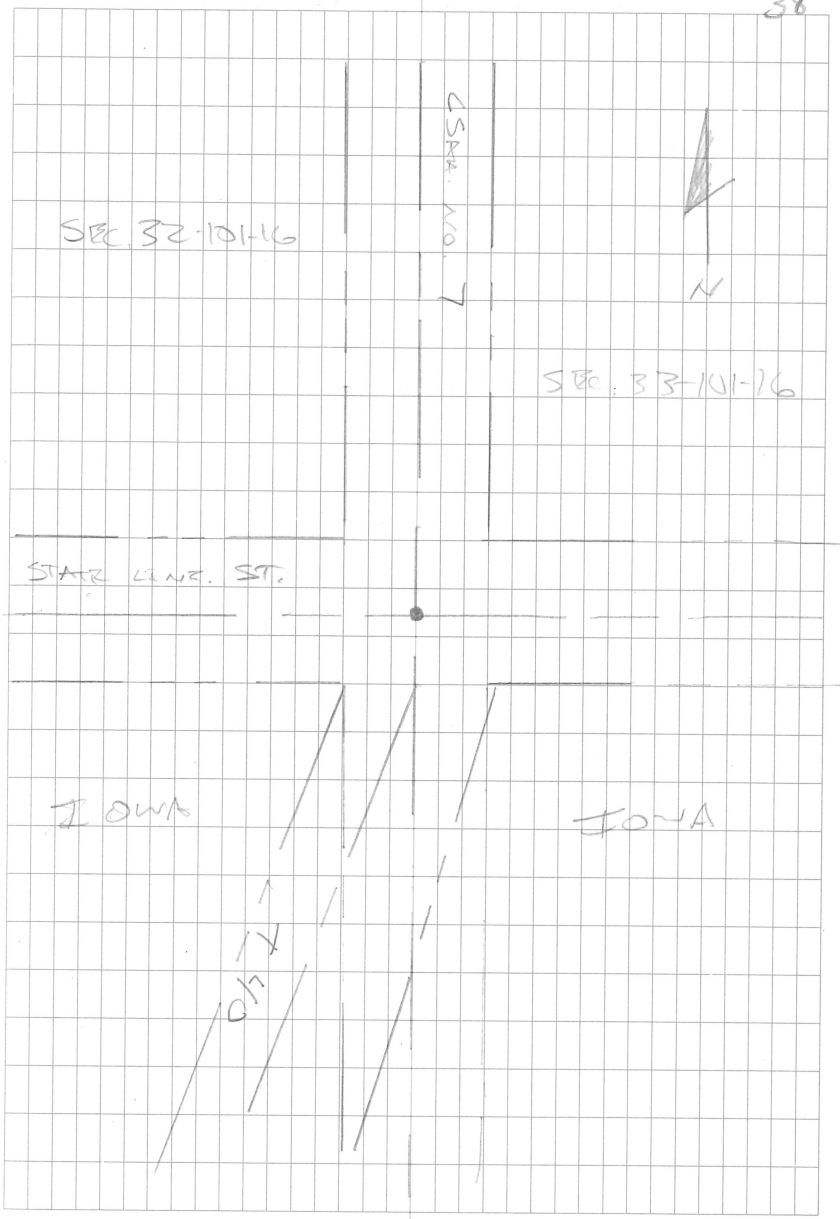


SE cor SEC. 32-101-16
Cert. Filed by JHS
Mower Co. Set CIM

12-15-82 JHS CREW UNCOVERED CIM,
SEE BOOK 237 pg 53

UNCOVERED SPK - REMOVED
SPK HAD Good DIP BELOW,

2-8-00
Cloudy & windy
30°
HLS
DEK
42

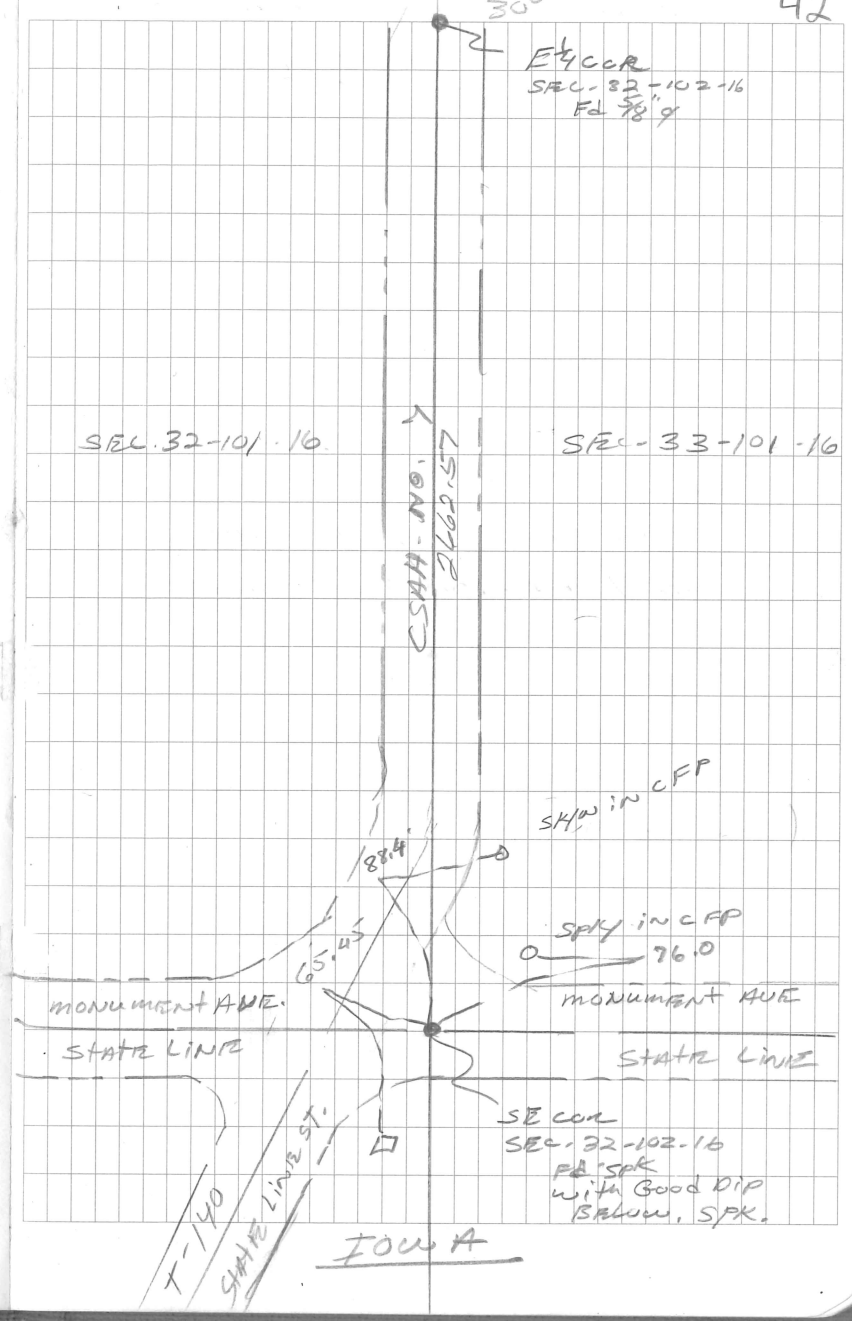

ADAMS Twp - South Line

SEC.'S 31 & 32

BS	① POL		⊙ spk/w
	④ SW cor SEC. 31		Fd ctm
D	3143.73		
FS	⑤	Iowa cor	Fd spk/w
∠	00°00'00"	3585.73	
FS	③ PC Line South Iowa		
∠	00°00'00"	941.48	
FS	② S¼ cor SEC. 31		⊙ spk/w
∠	00°00'00"	490.14	451.34
FS	⑥	Iowa cor	Fd ½" ø
∠	179°54'43"	1717.81	
FS	SE ⑦ cor SEC. 31		Fd ctm
∠	180°00'00"	2160.92	
FS	⑧ S¼ cor SEC. 32 on C&R Rd.		⊙ spk/w
∠	180°00'00"	4810.27	
FS	⑨ SE cor SEC. 32		Fd ctm
∠	180°01'42"	7463.98	

NH

8-14-02 Cloudy 75° HLS

59

