6-1-05
Cloudy
50°

HLS
MHS

31


Stone SEC 34-101-16

IN INFORMATION FOUND IN
MOWER Co. CORNER RECORDS

JHS CREW Dug with BOB BROS.
BACKHOE on ℄ of E-W Rd.
AND IN LINE with LINE
FENCE North.
APPEARS HILL WAS cut,
FOUND VIRGIN SOIL AT 1.5±
NO EVIDENCE of PLS CORNER

COMPUTED POS ON STRAIGHT
LINE BETWEEN SW COR
SEC 33 & SE COR SEC
34 & SINGLE P.P. DIST
NO MON SET

1/11/06 Set Capped 5/8" ø 13807
with GPS

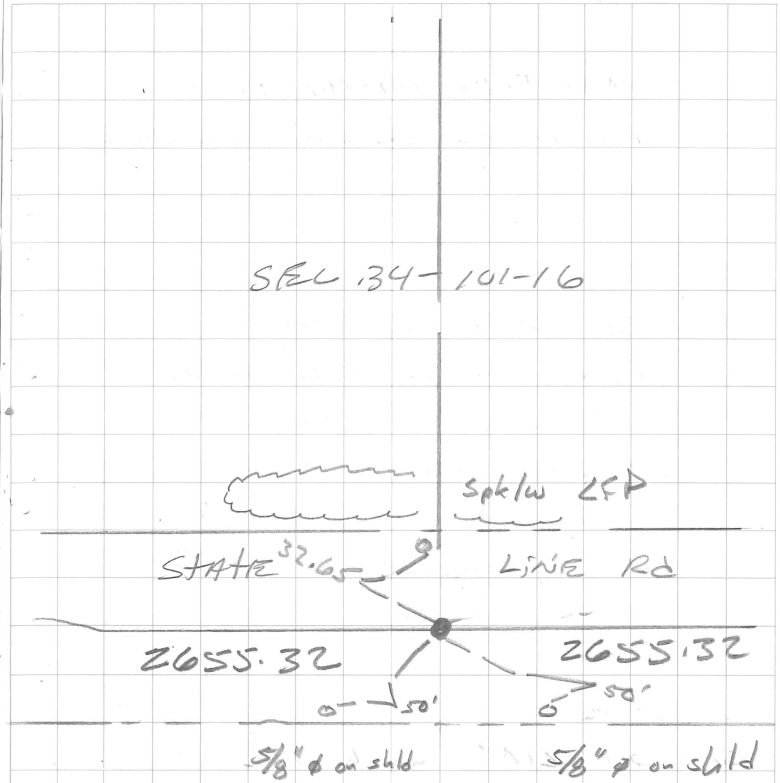

IOWA