S¼ COR SEC. 35-101-16

NO INFORMATION FOUND IN MOWER CO. CORNER RECORDS

JHS CREW dug with BOIE BROS. BACKHOE ON ℄ E-W Rd AT @ DIST of 2640.± EAST of SW COR SEC. 35.


Dug down to VIRGIN SOIL, 15" LONG HOLE, APPEARED to BEEN DUG BEFORE, CUT ALONG TRENCH ON NORTH SIDE.

FOUND NO EVIDENCE of PLS CORNER.

COMPUTED POS OF COR ON STRAIGHT LINE BETWEEN SEC CORS @ MIDPOINT- NO MON SET

1/11/06 SET CIM with GPS

6-1-05
CLOUDY
70°
HLS
MHS
29

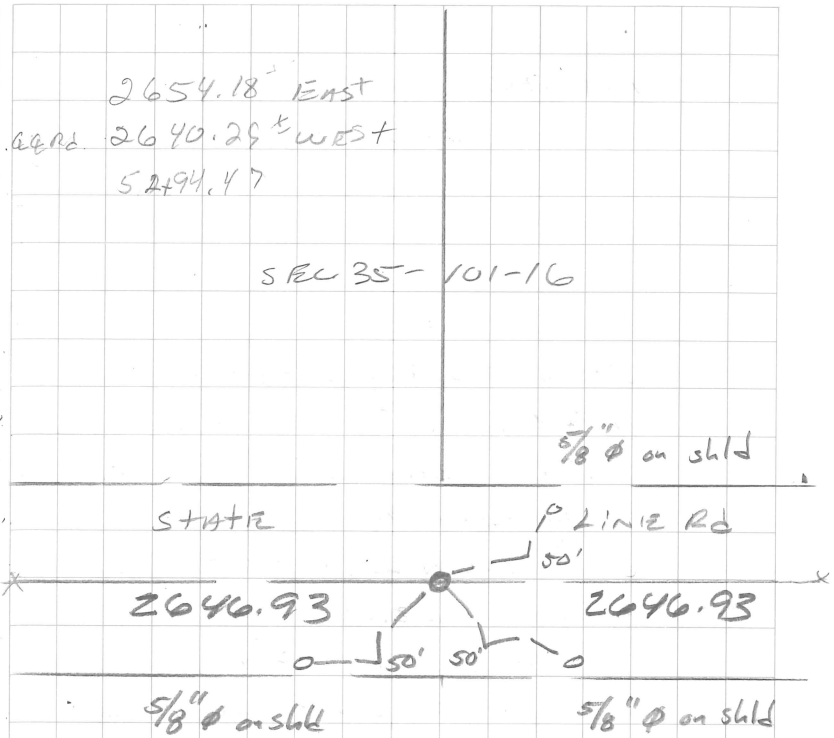

IOWA