
N¼ cor SEC. 4-101-7

NO INFORMATION FOUND
IN MOWER CO. RECORDS

AC NE cor SEC. 4
BS NW cor SEC. 4
D 5330.67
FS ½16th LINE N.
↓ 1331.0
FS ½16th LINE N.
↓ 3980.0

JHS CREW Dug with Mower
County Backhoe. Dug a
10'x10' HOLE down to clay IN
SOIL AND FOUND NO. EVIDENCE
of PLS CORNER.
SET CAST IRON MON ON STRAIGHT
LINE AND IN LINE WITH FENCE
SOUTH.

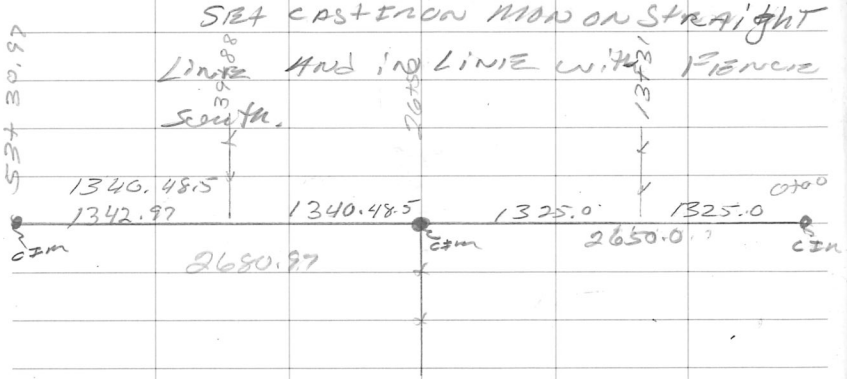

7-19-00 HLS
Cloudy 70° SJP

55

