
W 1/4 cor Sec 11 - 101 - 17

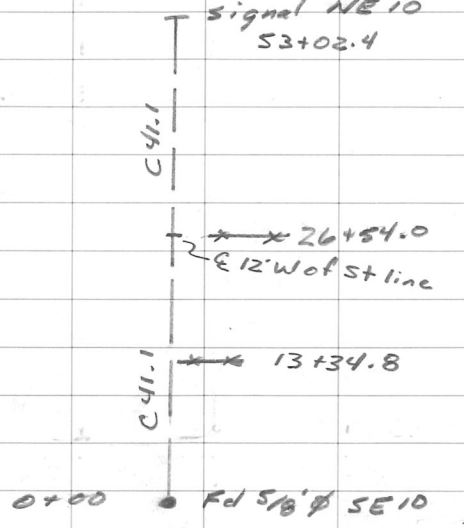

June 26, 1890 Clausen Field notes show Gov post @ cor.

Excav trench W Co. Backhoe & Fd nothing. Accepted & Twp Rd & Fence East as best evidence of perpetuation of orig PLS corner. Set CIM on ℄ in line W Fc.

(NOTE: NEED TO PULL TIES CIM DOES NOT SIGNAL WELL SAT)

10-9-96 SJT, TCF

