
SW COR. Sec. 16-101-17

Found capped 5/8"ø IRON
℄℄ N-S-E-W ROADS

SPK &W in PP SE 59.0
SPK &W in PP NW 60.0

Bk 328

25° 11-22-89 snow Windy DRR SLN ✓ 9

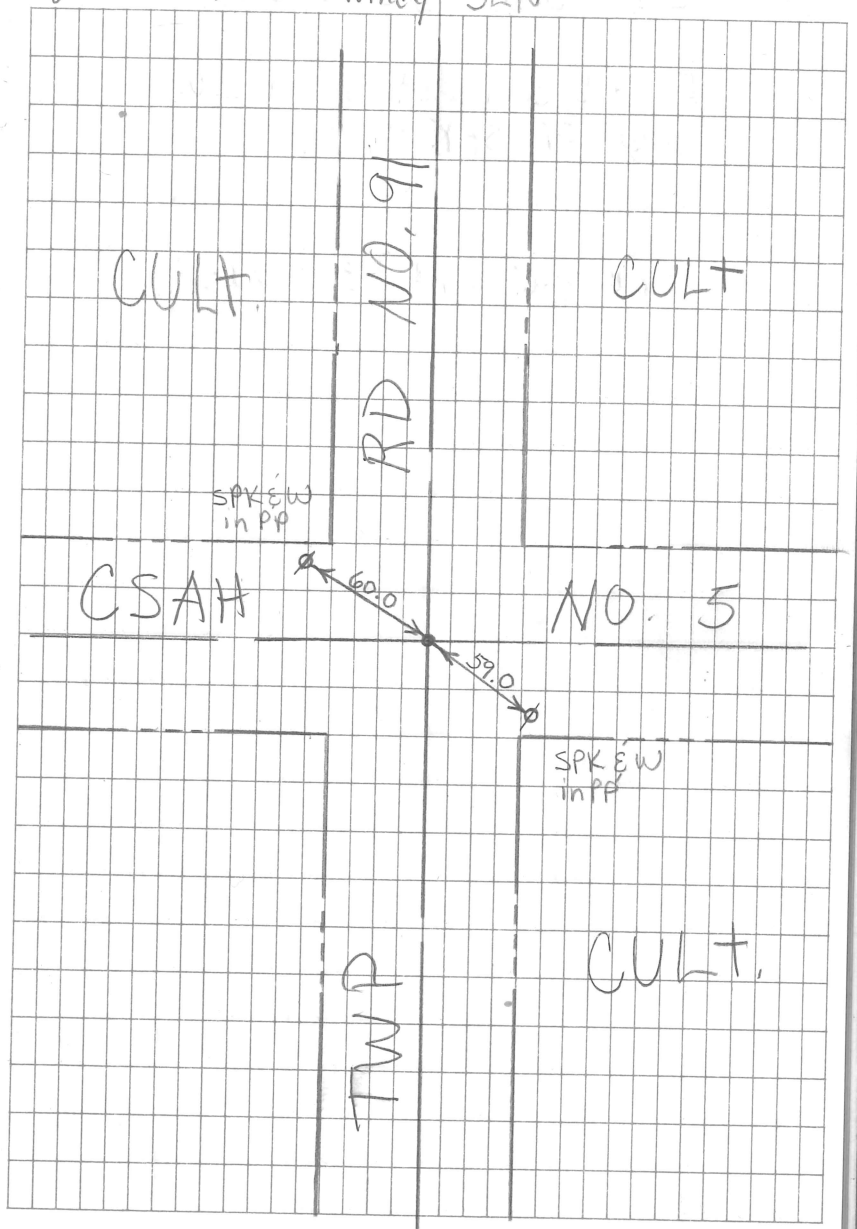

✓

SW Cor - Sec. 16-101-17

Bk 263, p. 31

FOUND CONC. MON. 2' DEEP AT ℄ ROADS N-S-E-W.

PLACED 5/8" ∅ OVER

8/19/4 SAT AKP FOUND CIM AT ROAD SURFACE PULLED TILS.

