5/8 con SEC. 16-101-17
Cert Filed by J.H.S. Inc

11-22-88 JHS CREW SET con.


JHS CREW COULDN'T LOCATE
con. FOUND HOLE IN Bitumn.
COULDN'T get SIGNAL FROM
LOCATOR.
USED DIST. FROM SEC.
BREAKDOWN SHEET AND RE SET,
SET TEMP 5/8" X 8 IRON.

5-7-02 SET CAST IRON MON. AND
TIED off.

8/19/4 SAT/AKP FOUND NO SIGNAL ON CIM &
5/8 Ø ON SHLD'S. ROAD HAS RECENTLY
BEEN REPAVED

1-10-02 HLS
CLOUDY CPU

59

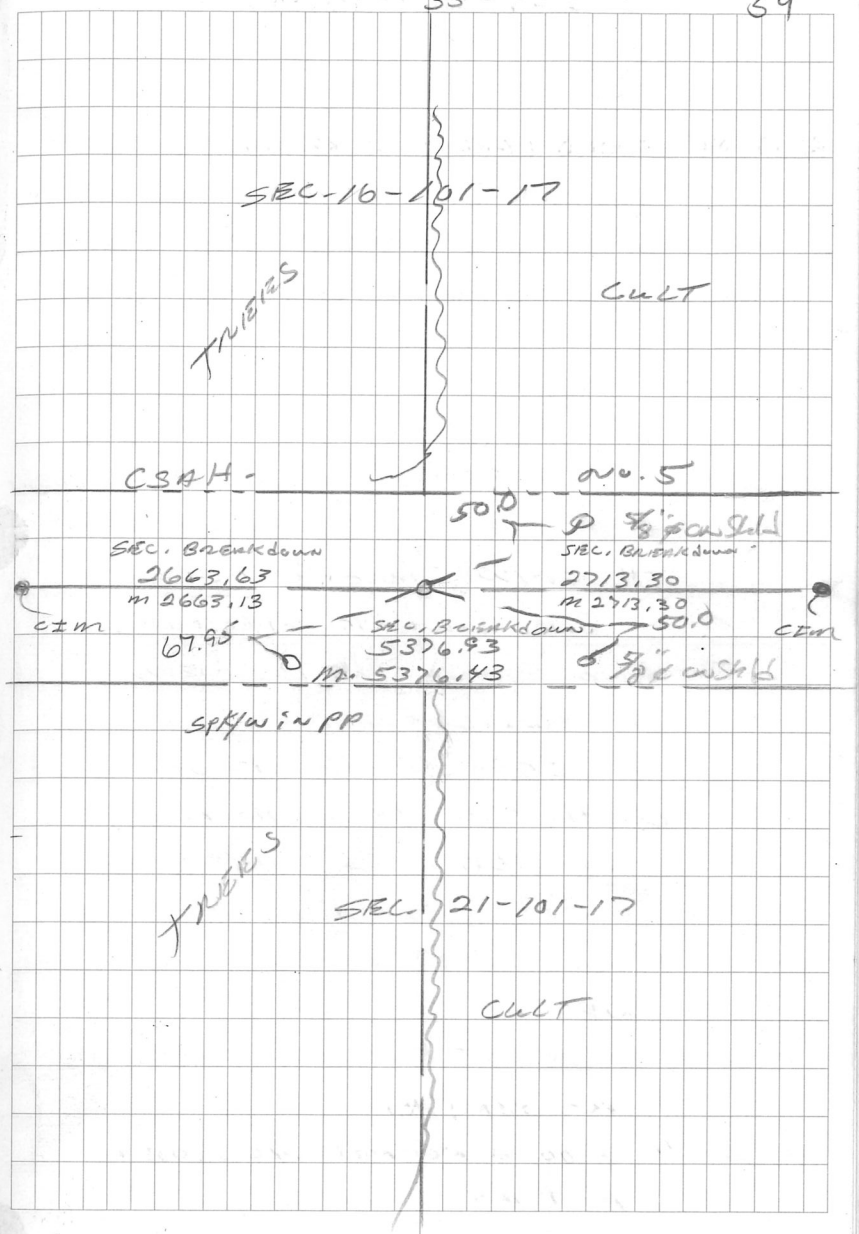

S 1/4 COR. Sec. 16-101-17

Found concrete Nail & W
over RR SPK & E-W ROAD
division (WOODS N-S)

SPK & W in PP SE 103.3

25° 11-22-89 snow Windy DRR SLN ✓ 10

