
NW Cor Sec 22-101-17

Found 5/8" ø iron
capped RLS 13807
Placed by JHS in
1984±, uncovered
in 11-22-89 and
corner cert. filed
Set CIM over 5/8"ø
at this time

SEE 1989 Corner Cert.

Cert. filed under SE 16-101-17

4-21-91 DRR — 2.

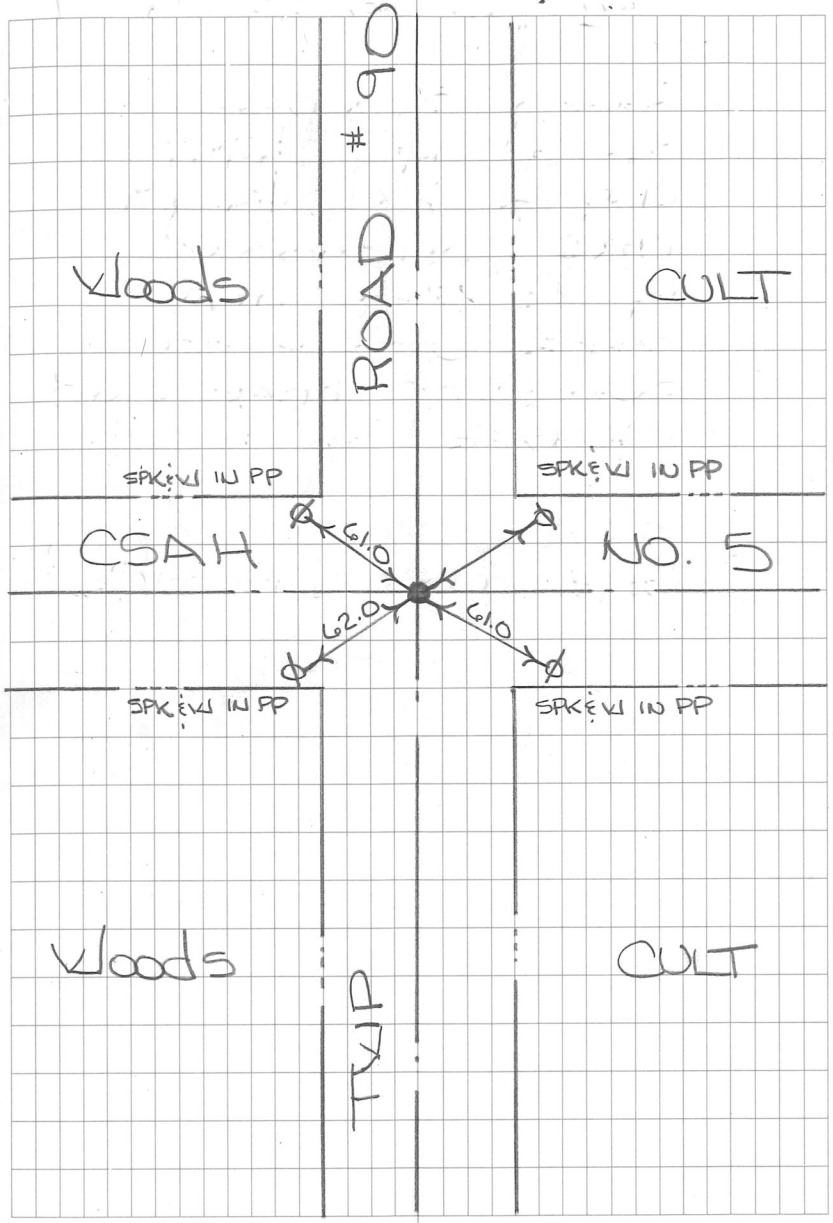

SE COR. Sec. 16-101-17

Cert Filed 9-18-90

Found capped 5/8" ø IRON

℄ ℄ N-S-E-W ROADS

SPK & W in PP's

NW 61.0'

NE 63.5'

SE 61.0'

SW 62.0'

11-22-89

DRR

SLN ✓ 11

