7-16-96

JHS IV
KJS


S 1/4 COR SEC 30-101-17

cert. Filed 7-31-96

5002.27
609.91
5612.18
VS GOV 5610.0

PP 2641.03 VS 2608.03 TO FNC N.
2361.24
131E

COR WAS EXCAVATED FOR WITA BACKHOE, BUT NO MON FOUND MOWER CO. HWY DEPT SHOWS NO RECORD OF THIS COR. SET MON @ INTER OF FENCE LINE TO NORTH & ST LINE BETWEEN SEC CORS, THIS POS. IS 33' EAST OF LOST POSITION, BUT FITS EXISTING OCC. & FENCE LINES IN SEC 30 & 31-101N-R17W.

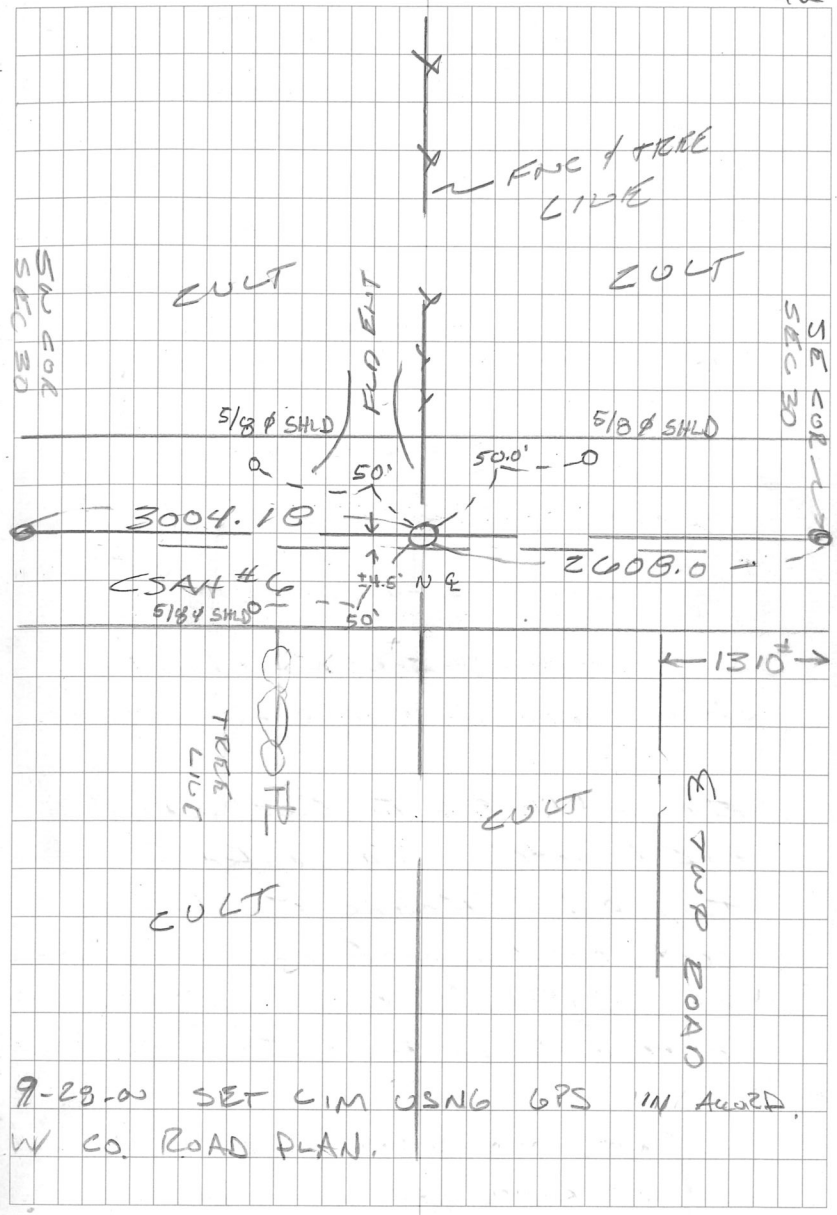

9-28-00 SET CIM USNG GPS IN ACCORD. W CO. ROAD PLAN.