
7-2-96
Cloudy.
80°

HLS

33

Sly cor SEC. 31 - 101 - 17

cert. Filed 7-31-96

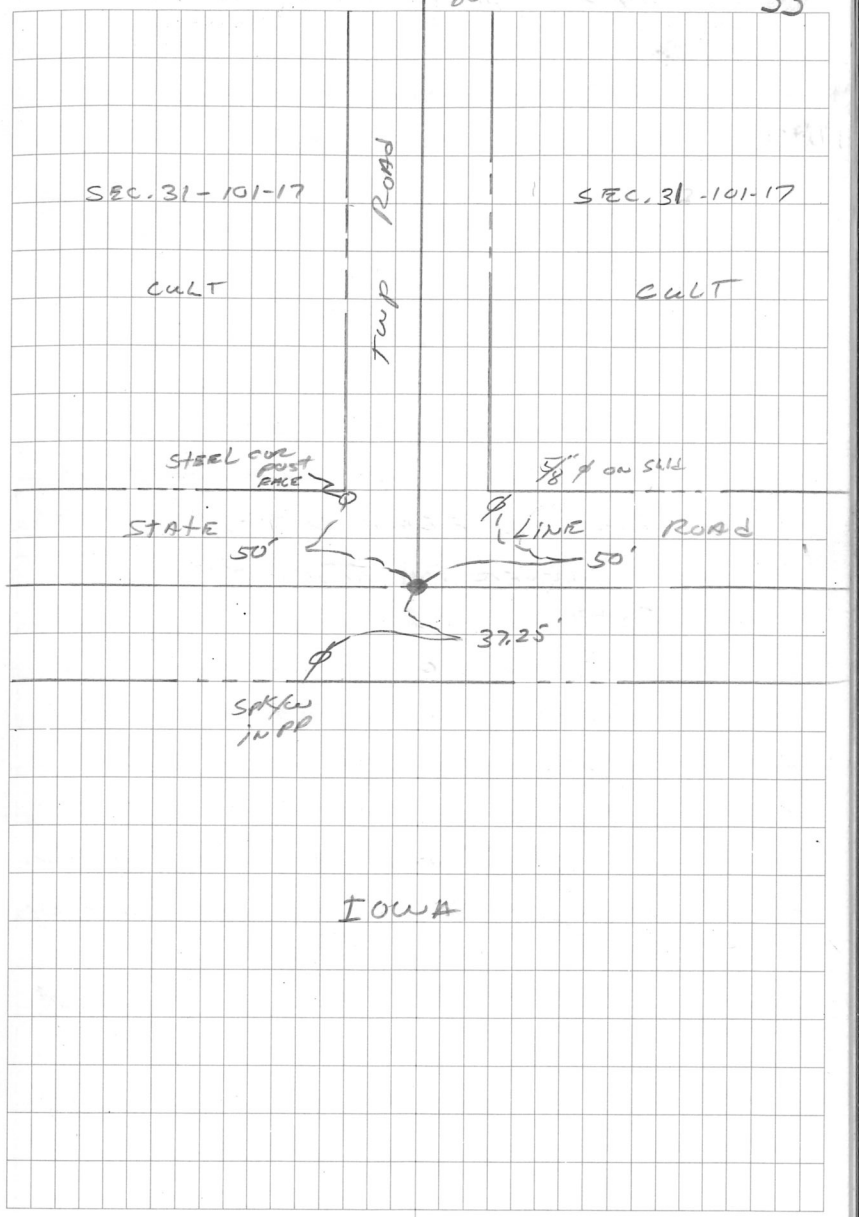

THIS CREEK Dug by Hand AND UNCOVERED 5/8" IRON. SET CAST IRON MON OVER 5/8" ø FOUND. THIS LOCATION IS IN AGREEMENT WITH PLATS IN CITY OF LYLE & IOWA RECORDS & MOWER CO HWY DEPT RECORDS